

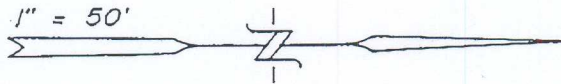


Plat of Survey of Land in Sec. 23 T6SR7E
City of Hammond, La.

University Ave.

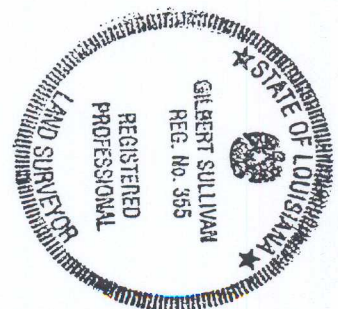

P.O.B. is the S/W Cor. of Lot 6
of a Sub. of Record by C.M. Moore dated 4/29/61

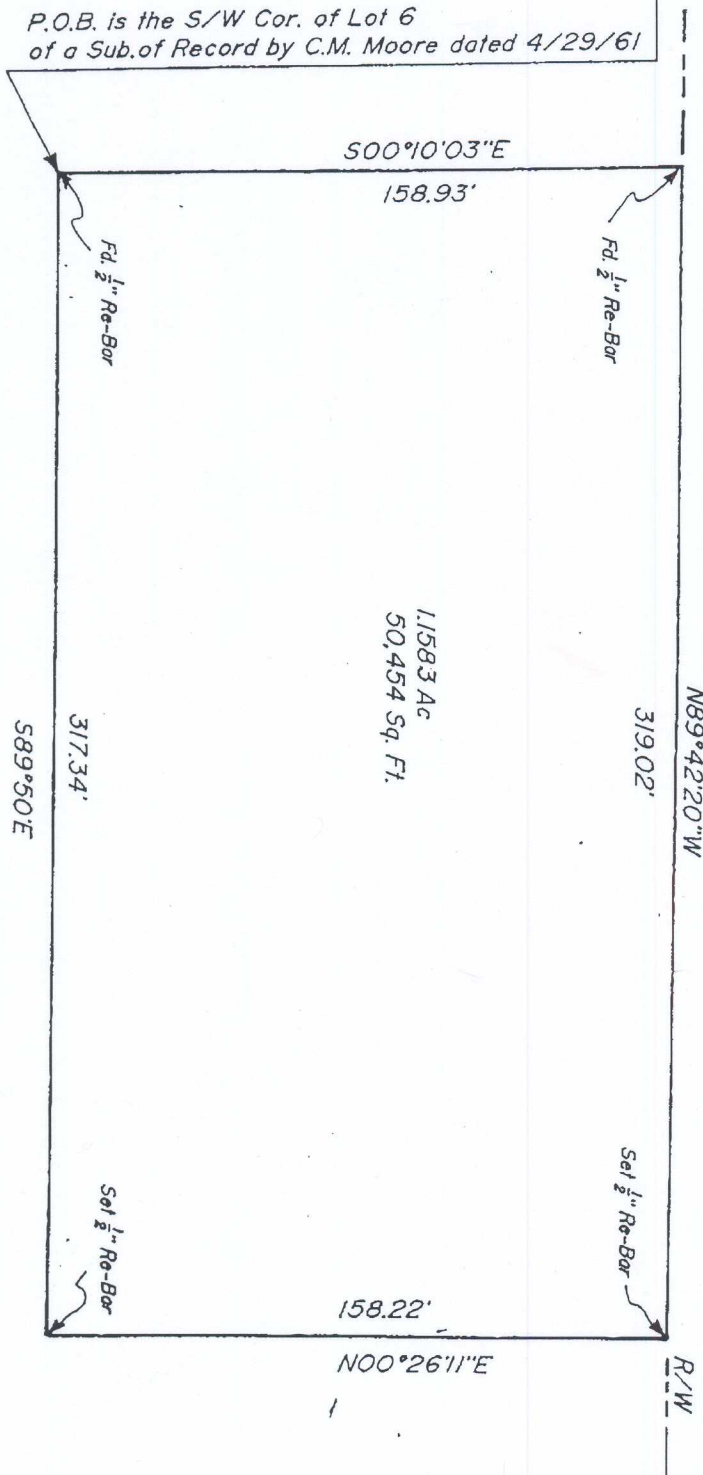

This survey was performed by myself and meets
the Minimum Standards of Practice requirements
for a class C survey.

[Signature]
5/30/06