


REVISION	DATE

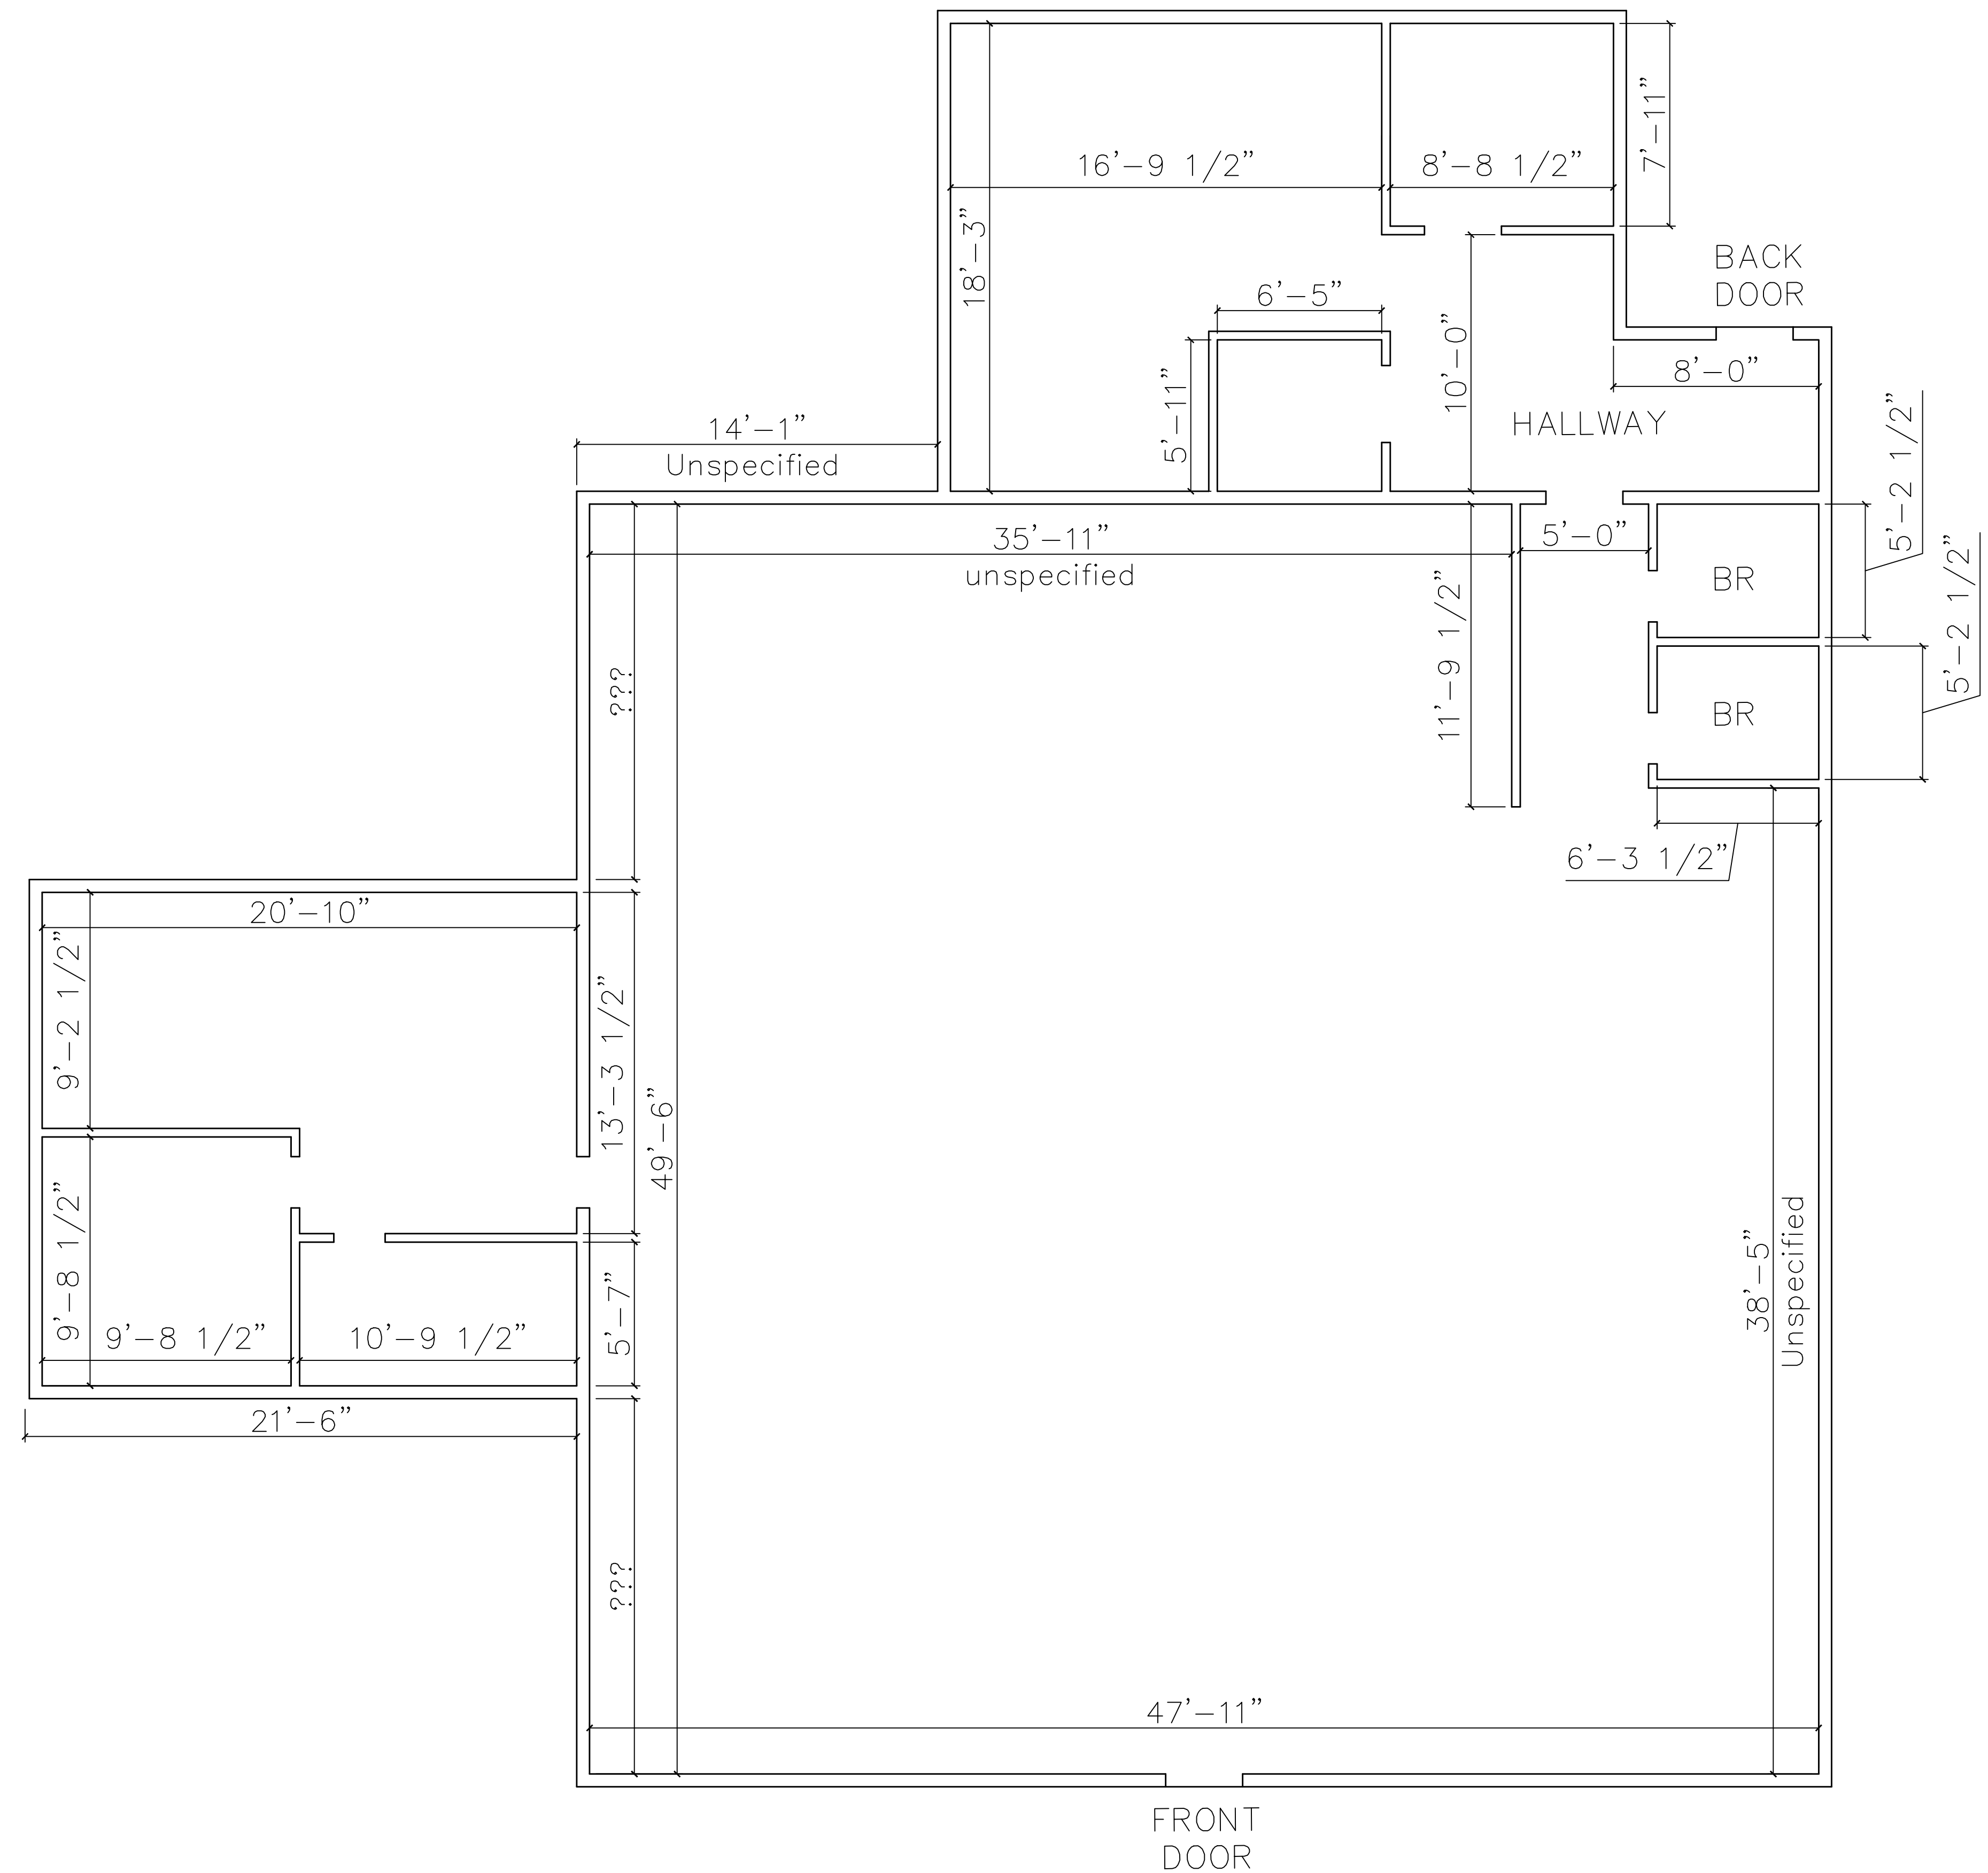

SUITE 1 - 4,221 SqFt
 SCALE: 1/4" = 1'-0"

MEASUREMENTS FOR
DEVILLE PLAZA
SUITE 1
 5250 I-55
 Jackson, MS 39211

DATE AUG. 10, 2023
 DRAWN FOR B. COOK
 DRAWN BY Z. SLAY

SHEET TITLE	SHEET #
Suite 1	a1