


REVISION	DATE

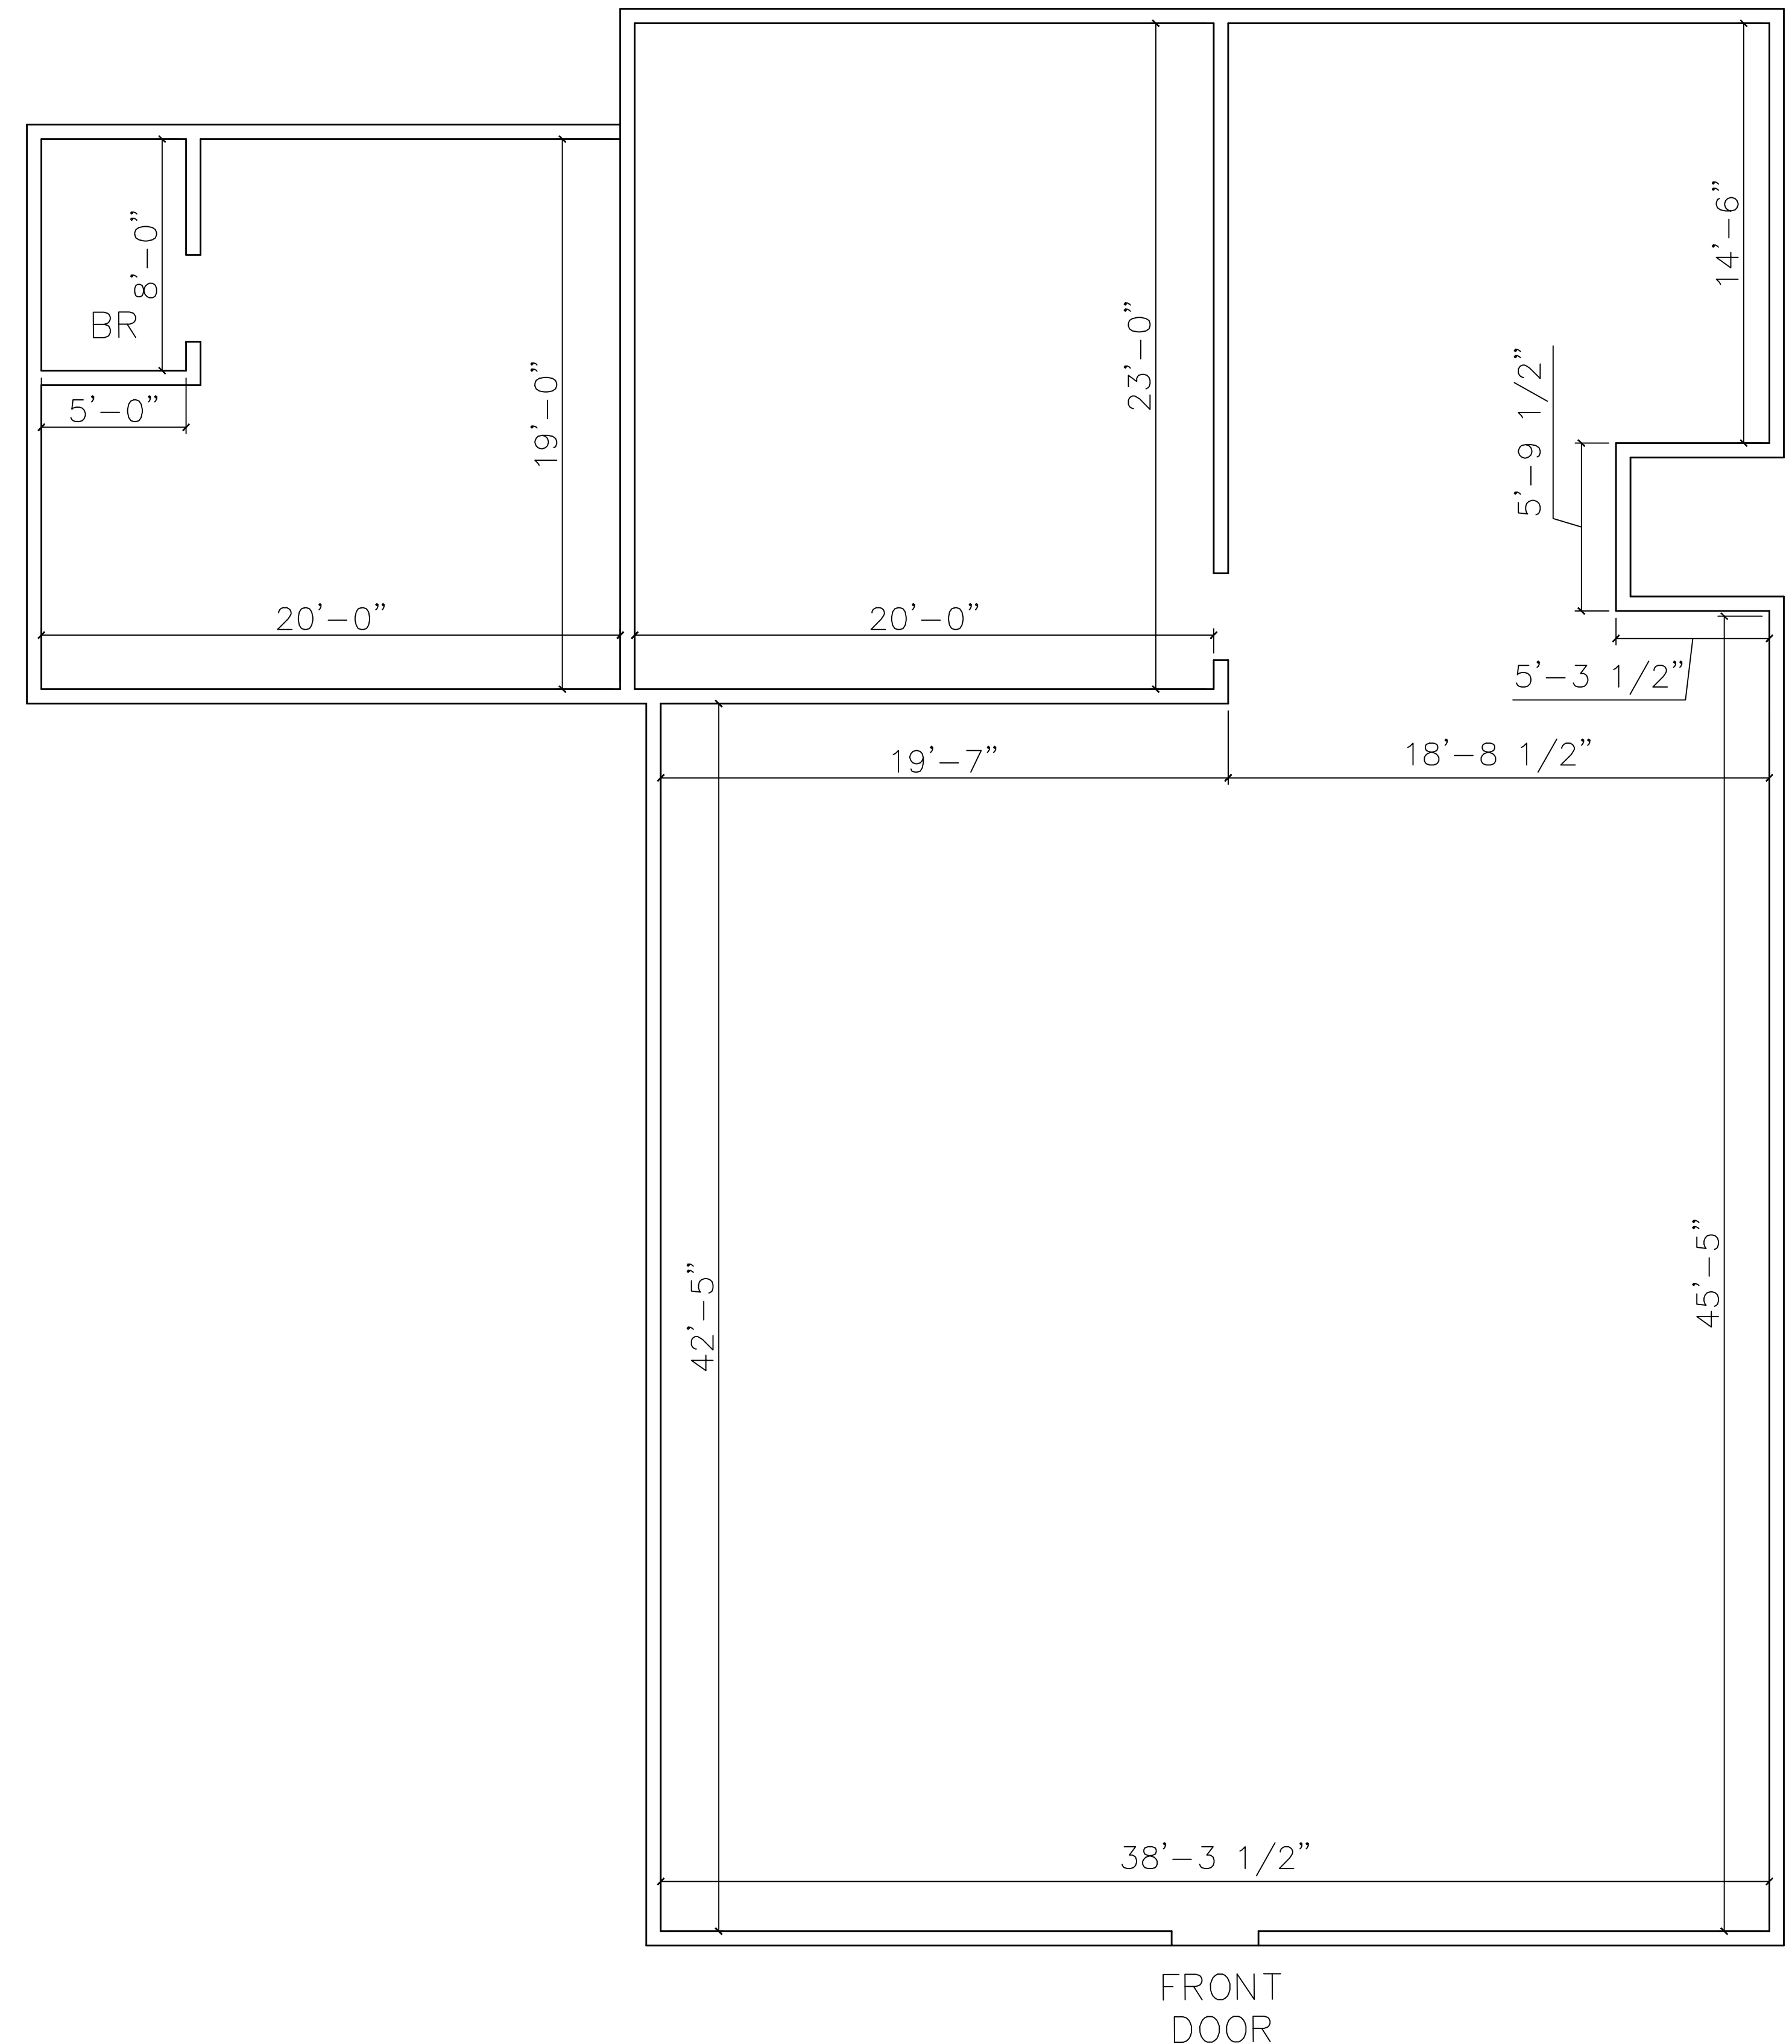

SUITE 13 - 3,141 SqFt
SCALE: 1/4" = 1'-0"

MEASUREMENTS FOR
DEVILLE PLAZA
SUITE 13
5250 I-55
Jackson, MS 39211

DATE AUG. 10, 2023
DRAWN FOR B. COOK
DRAWN BY Z. SLAY

SHEET TITLE	SHEET #
Suite 13	a5