
SURVEY OF A 2.4972 ACRE TRACT LOCATED IN SECTION 36, T6S–R7E TANGIPAHOA PARISH, LA.

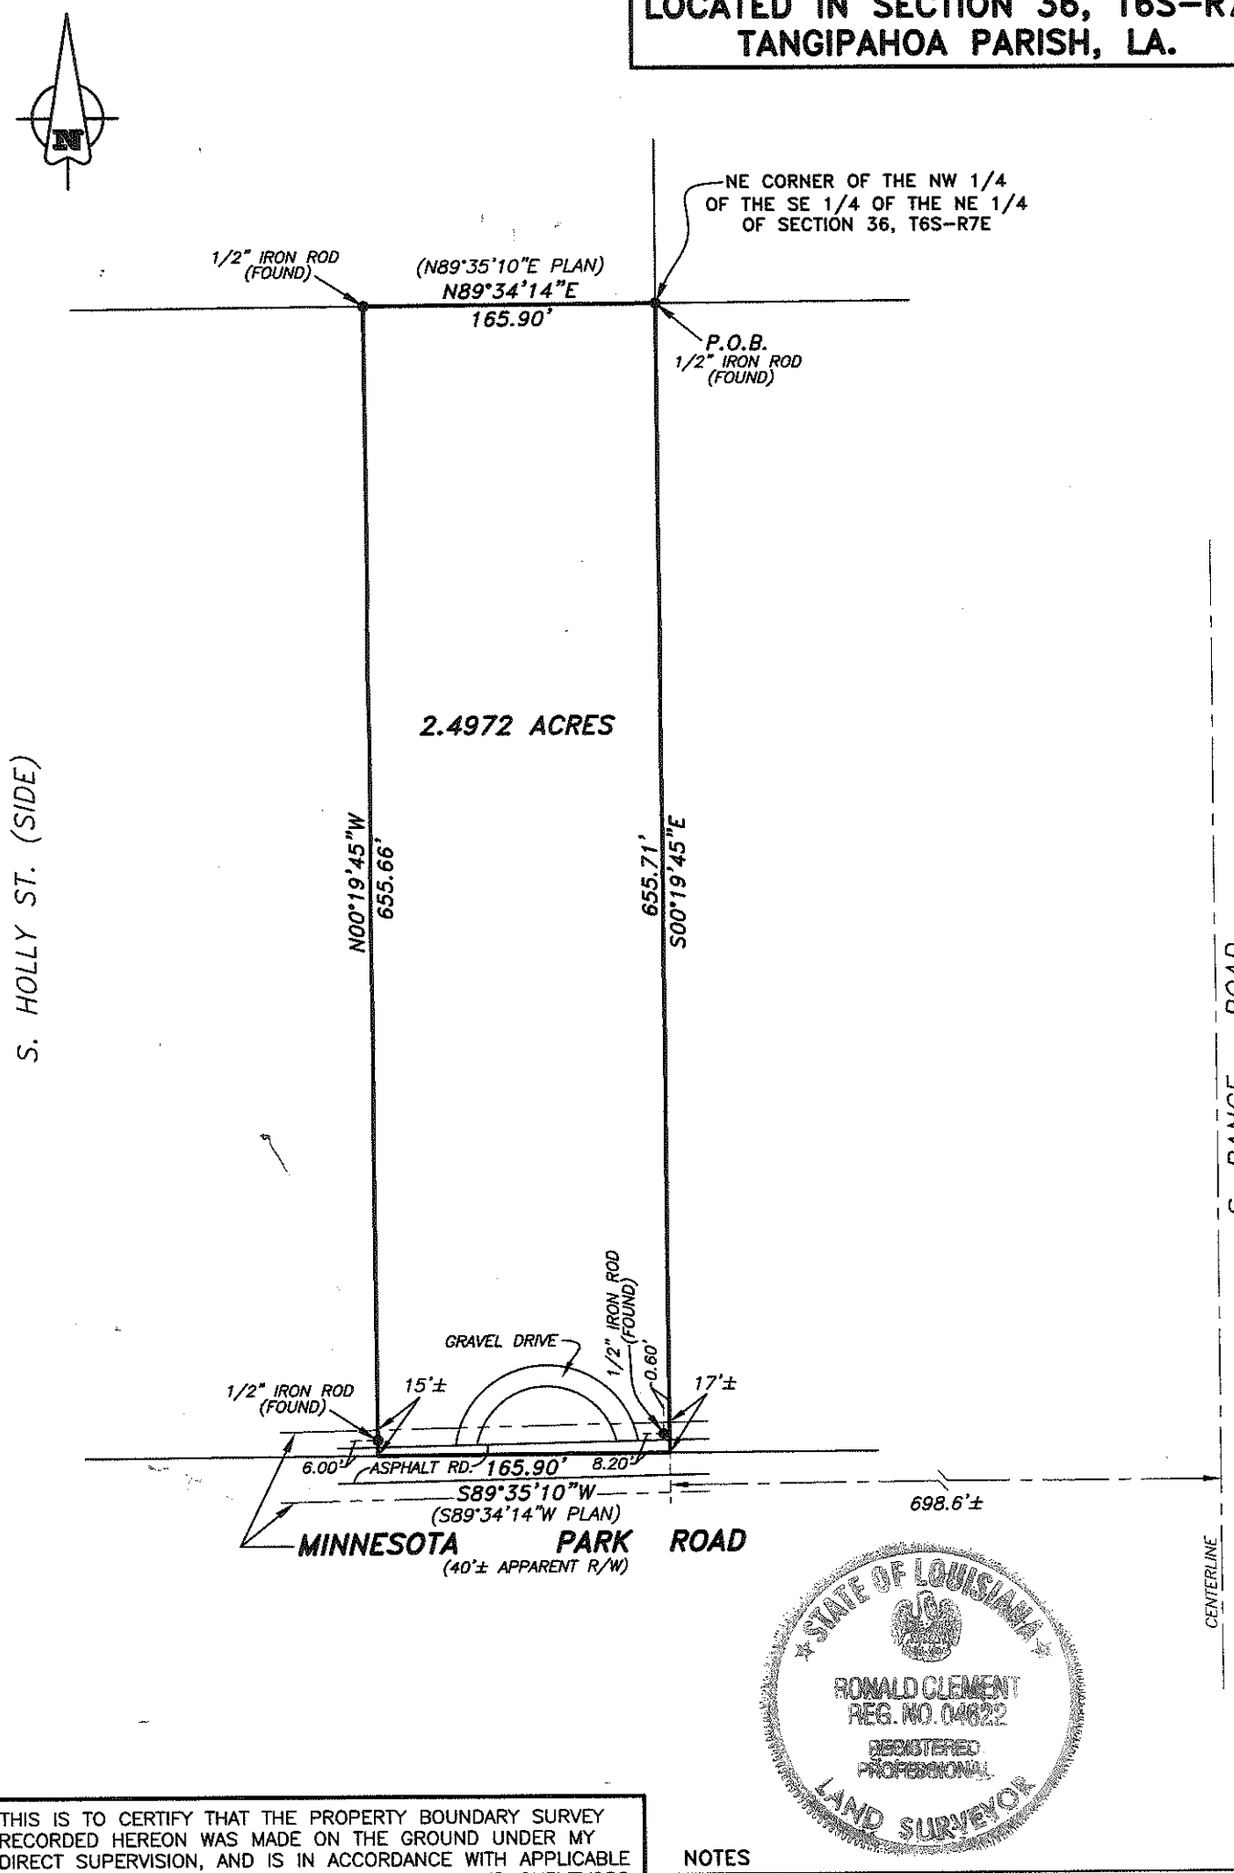

STATE OF LOUISIANA
RONALD CLEMENT
REG. NO. 04622
REGISTERED PROFESSIONAL
LAND SURVEYOR

THIS IS TO CERTIFY THAT THE PROPERTY BOUNDARY SURVEY RECORDED HEREON WAS MADE ON THE GROUND UNDER MY DIRECT SUPERVISION, AND IS IN ACCORDANCE WITH APPLICABLE STANDARDS OF PRACTICE FOR PROFESSIONAL LAND SURVEYORS AS STIPULATED IN LOUISIANA ADMINISTRATIVE CODE TITLE 46:LXI, CHAPTER 25 FOR A CLASS "C" SURVEY.

PREPARED AT THE REQUEST OF
TOM K. BUILDERS, LLC

BY _____

RONALD CLEMENT, P.L.S.
LA. REGISTRATION No. 4622

M AND N LAND SURVEYING, LLC
74232 HWY. 25, COVINGTON, LA. 70435
PHONE: 985-871-0280 FAX: 985-871-0290

NOTES

THE SUBJECT PROPERTY IS LOCATED IN FLOOD ZONE "X" PER F.I.R.M., COMMUNITY NO. 220206, PANEL 0225 E, REVISED 8/23/00.

THIS PLAN DOES NOT REPRESENT A LEGAL OPINION OF TITLE, AND SHALL NOT BE RELIED UPON FOR THAT PURPOSE. ALL APPLICABLE SERVITUDES MAY NOT BE SHOWN.

CERTAIN FEATURES MAY BE EXAGGERATED IN SCALE FOR CLARITY. DIMENSIONS SHOW ACTUAL LOCATION.

SURVEYED IN ACCORDANCE WITH THE LOUISIANA MINIMUM STANDARDS FOR PROPERTY BOUNDARY SURVEYS FOR A CLASS "C" SURVEY.

BEARINGS ARE BASED UPON A PLAN OF SURVEY OF A 2.50 ACRE TRACT LOCATED IN SECTION 36, T6S–R7E, TANGIPAHOA PARISH BY ANSIL BICKFORD, DATED 6/29/98.

DATE: 6/02/06 *SCALE: 1"= 100'* *PROJECT: 06–125*

ID - C:\survey\dwgs\Subd\Tangipahoa\Section 36 T6S-R7E\06-125 minnesota park.dwg - Tue, 6 Jun 2006 - 14:45