


SQ. NO. 206
SECOND DISTRICT
(Lot 1)

ORLEANS PARISH
NEW ORLEANS, LA

N. DERBIGNY ST. SIDE

URSULINES AVE. SIDE

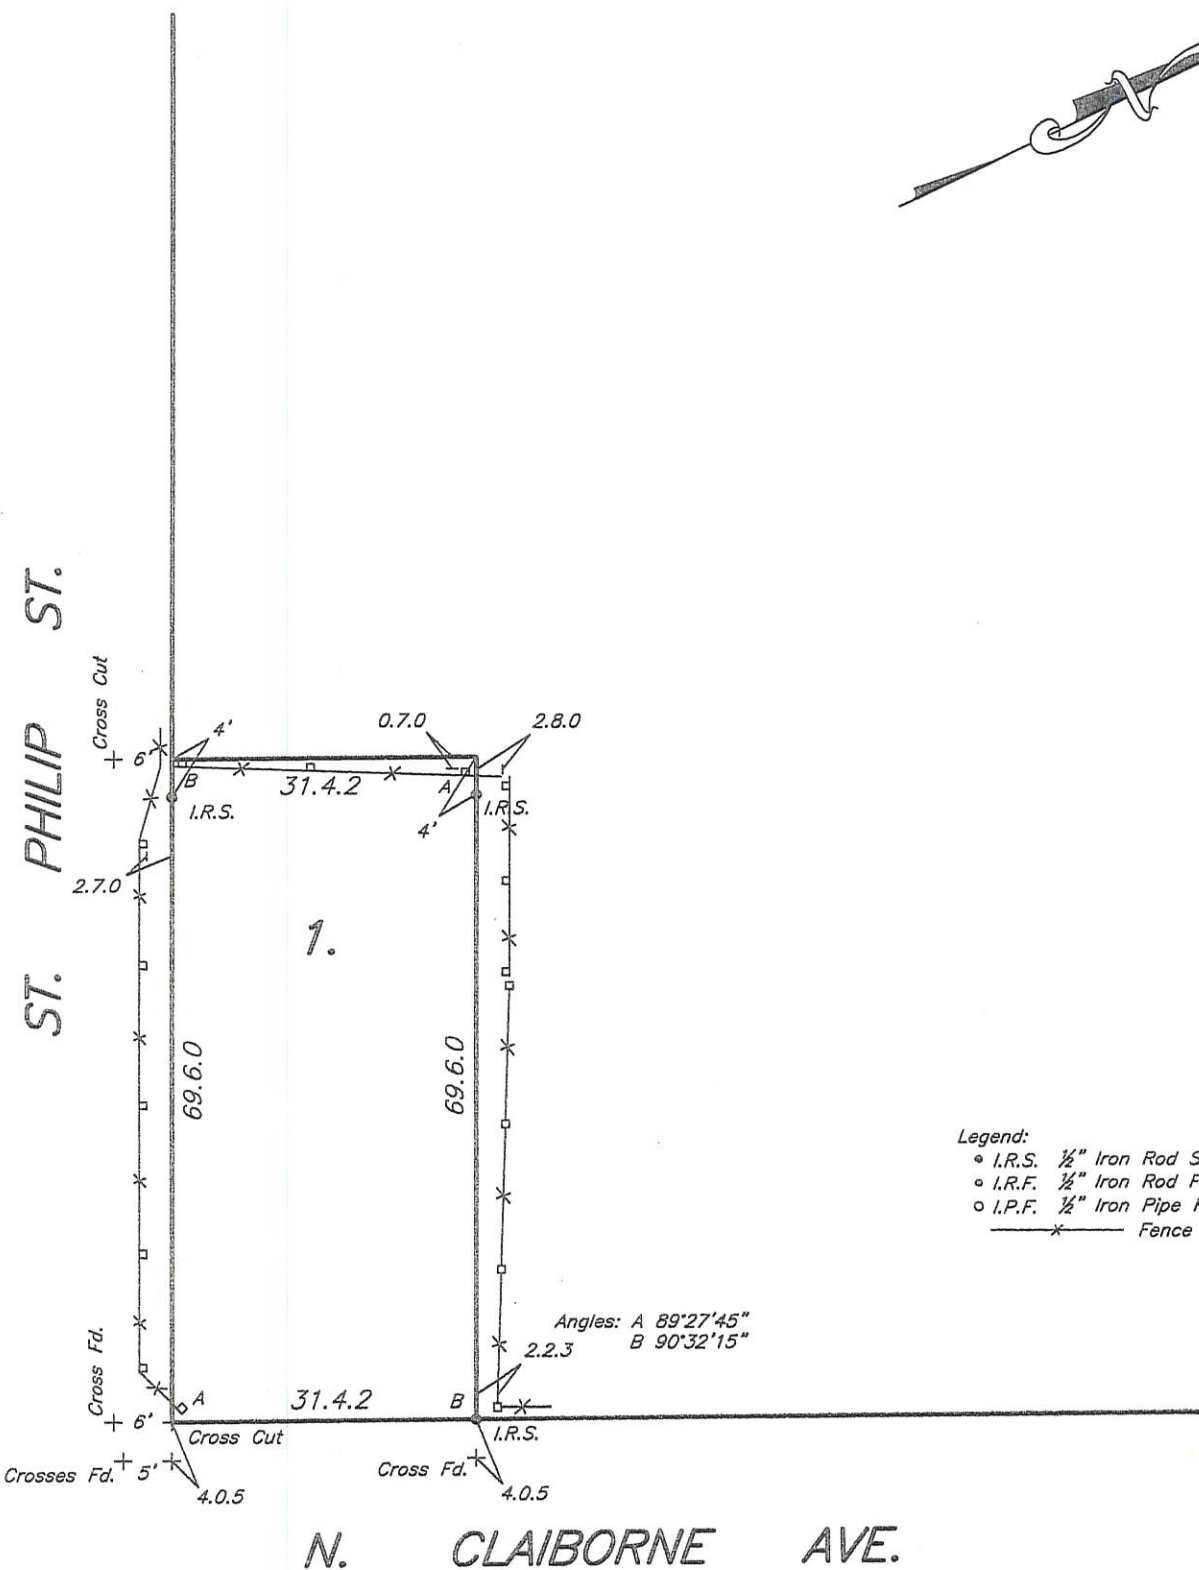

- Legend:
- I.R.S. 1/2" Iron Rod Set
 - I.R.F. 1/2" Iron Rod Found
 - I.P.F. 1/2" Iron Pipe Found
 - x — Fence

THE SERVITUDES AND RESTRICTIONS SHOWN ON THIS SURVEY ARE LIMITED TO THOSE SET FORTH IN DESCRIPTION FURNISHED US AND THERE IS NO REPRESENTATION THAT ALL APPLICABLE SERVITUDES AND RESTRICTIONS ARE SHOWN HEREON. THE SURVEYOR HAS MADE NO TITLE SEARCH OR PUBLIC RECORD SEARCH IN COMPILING THE DATA FOR THIS SURVEY.

Note:
Improvements may not be to scale for clarity.
The dimensions shown prevail over scale.

All lot angles as per plan of sub.

Date: May 11, 2020

Scale: 1" = 20'

This plat represents an actual ground survey made by me or under my direct supervision and control and meets the requirements for the Standards of Practice for Boundary Surveys as found in Louisiana Administrative Code TITLE 46:XXI, Chapter 29 for a Class "C" survey.
Made at the request of Dr. Robyn Williams.

Gilbert, Kelly & Couturie, Inc., Professional Land Surveying
2121 N. Causeway Blvd., Metairie LA 70001 (504) 836-2121

Clint L. Williams