
3545 N. I-10 Service Road
Metairie, Louisiana

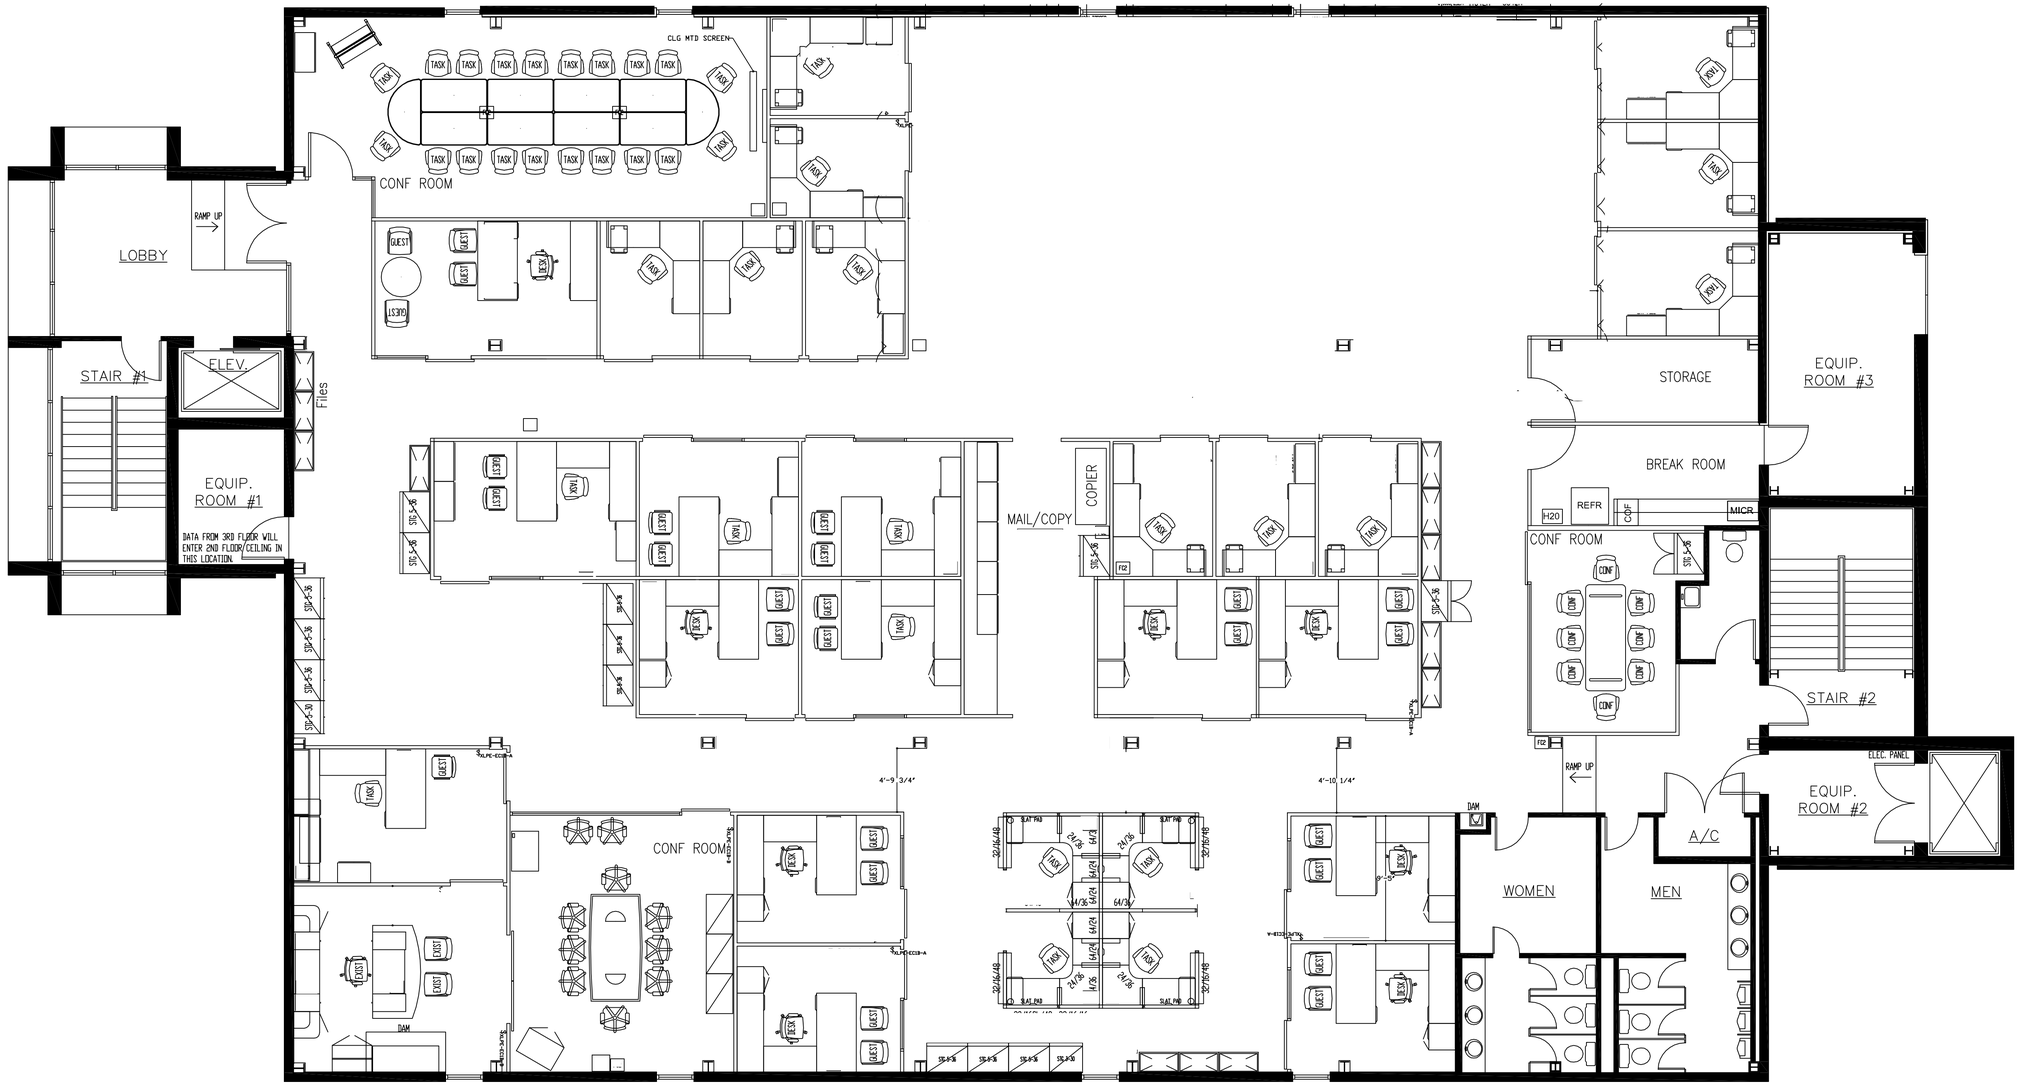


Suite 200