


SKETCH

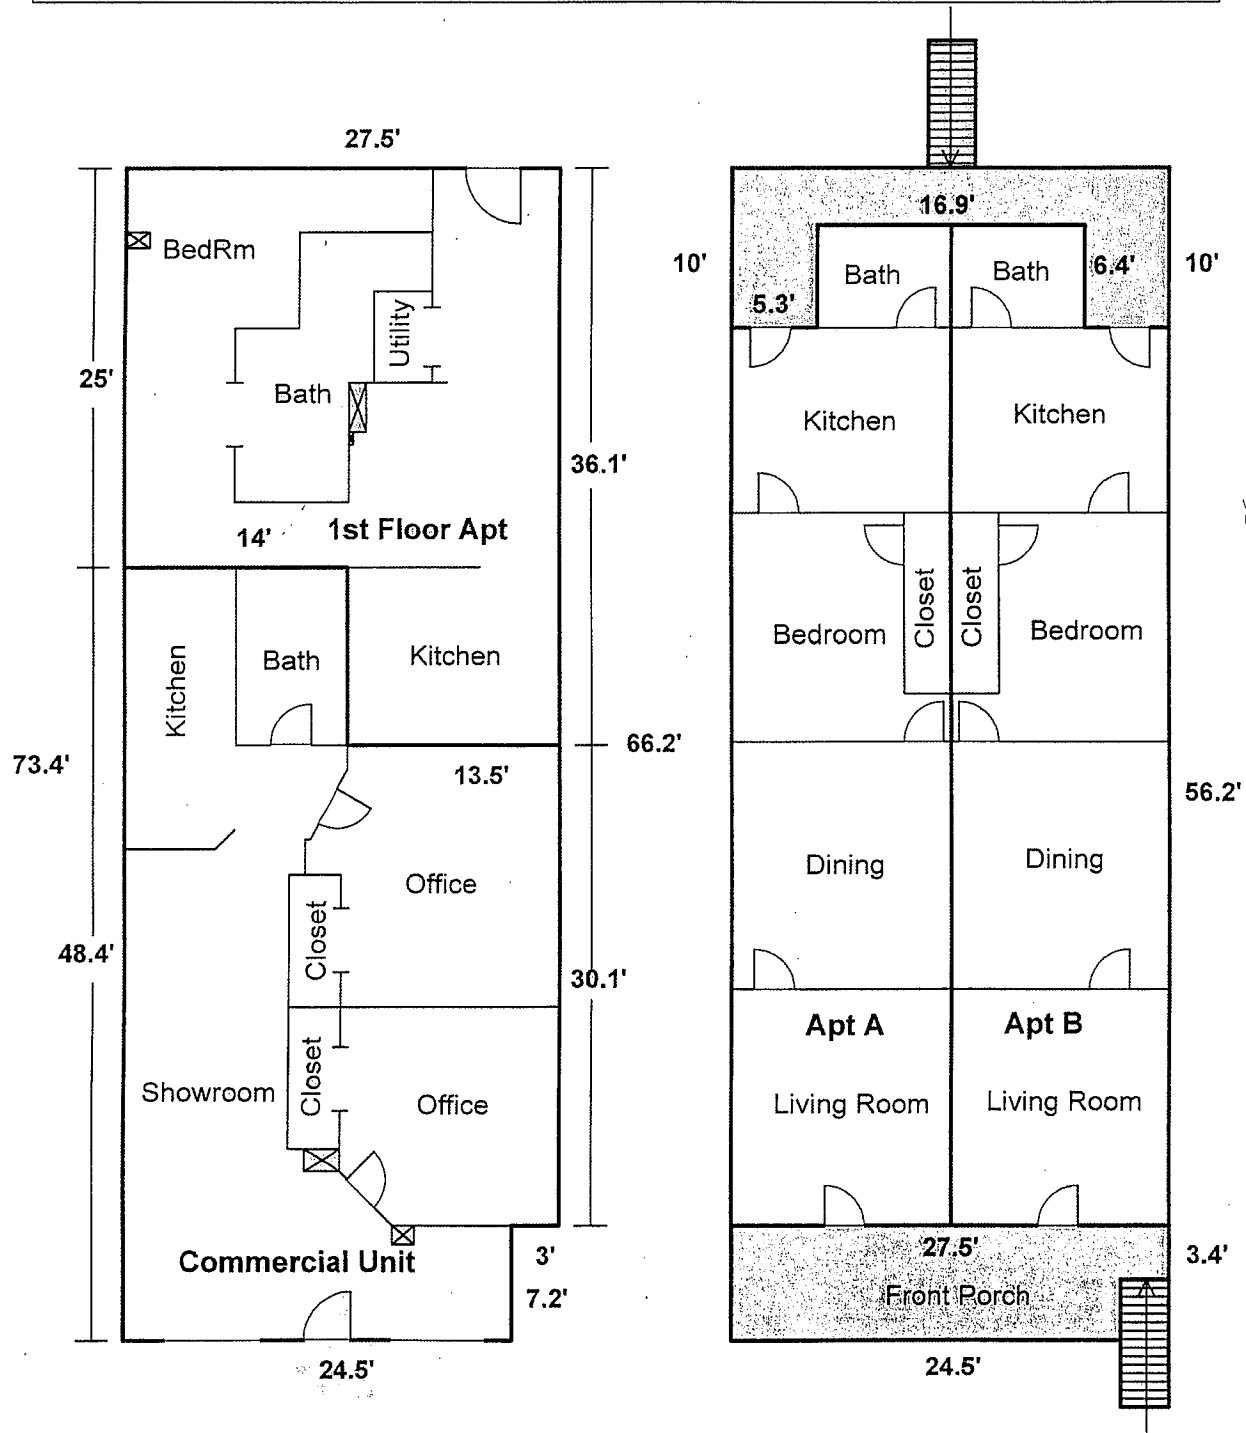

A. B. Miles


Andrew B. Miles

SKETCH-IT 1-800-523-0872

08181.SKT

SQ. No. 23, HURSTVILLE
SIXTH DISTRICT

NEW ORLEANS, LA.
ORLEANS PARISH

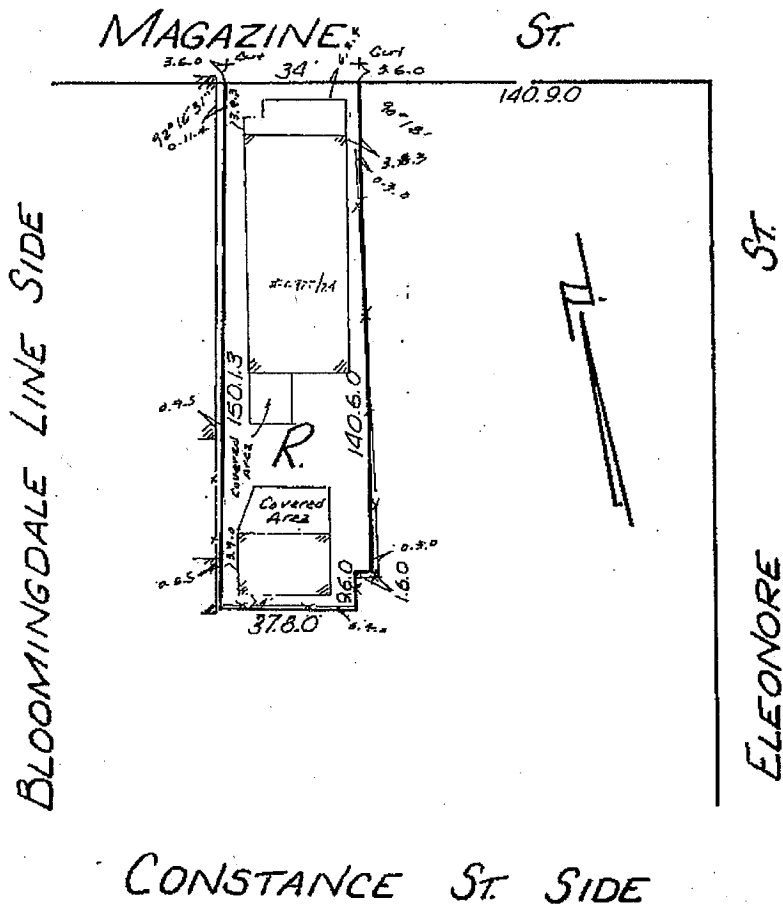

Note:
Improvements may not be to scale for clarity.
The dimensions shown prevail over scale.

THE SURVEYORS SHOWN ON THIS PLAT ARE LIMITED TO
THOSE FURNISHED TO US. THERE IS NO REPRESENTATION
THAT ALL APPLICABLE SERVITUDES ARE SHOWN HEREON.
THE SURVEYOR HAS MADE NO TITLE SEARCH OR PUBLIC
RECORD SEARCH IN COMPILING DATA FOR THIS SURVEY.

THE FEDERAL INSURANCE ADMINISTRATION FLOOD HAZARD
BOUNDARY MAP INDICATES THAT THE ABOVE DESCRIBED
PROPERTY IS LOCATED IN FIA ZONE "B"

Date: July 20, 2005

Scale: 1" = 30'

This plat represents an actual ground survey made by me or under my direct supervision and control and meets the requirements for the minimum standards for Property Boundary Surveys as found in Louisiana Administrative Code Title 46:XXI, Chapter 25 for a Class "C" survey.

Made at the request of First Bank & Trust, 333 Poydras Street, New Orleans, LA 70112, LLC

Gilbert, Kelly & Couturie, Inc., Surveying & Engineering
2121 N. Causeway Blvd., Metairie LA 70001 (504) 836-7421

REGISTERED
PROFESSIONAL

49585