

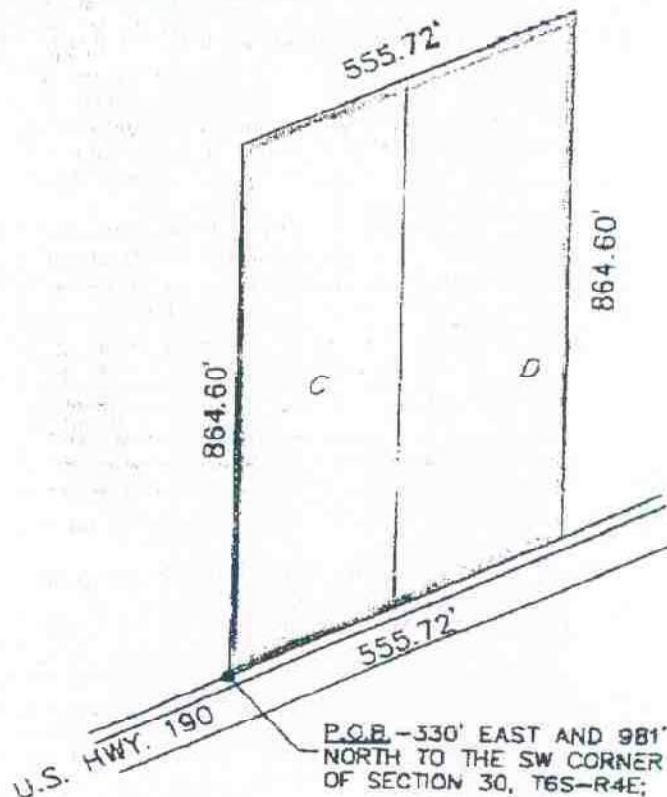
89/18/2006 14:31 5044290333

HYDRIK

PAGE 02

DESCRIPTION OF PROPERTY
TO ACRES

BEGIN AT A POINT 330' E AND 981' N TO THE SW CORNER OF SECTION 30, T6S-R4E, OF 20 ACRES, THENCE N 65°0'00" E TO POINT OF BEGIN, (P.O.B.). THENCE PROCEED N 0°10'00" E 864.6'; THENCE N 65°0'00" E 555.72'; THENCE S 0°10'00" W 864.6' TO THE R/W OF HWY. 190; THENCE ALONG SAID R/W S 65°0'00" W 555.72' TO THE P.O.B. CONTAINING 10 ACRES IN SECTION 30, T6S-R4E.

APPROVED
JURISDICTIONAL DETERMINATION

USACE

IH w/ Prev. determination

GASPARD

7 DEC 2011

FOR ROGERS

(# MN2011-02683-SE)



= NON-WETLAND

SCALE: 1" = 300'
JOB NO. 194714WETLANDS DETERMINATION
"HWY. 190"ALVIN FAIRBURN & ASSOC., INC.
CONSULTING ENGINEERS
LAND SURVEYORS ~ DESIGNERS
1110 South Range Avenue, Denham Springs, LA