



RECEIVED. 8/20


LOUISIANA REGISTERED LAND SURVEYOR

CERTIFIED CORRECT

THIS IS IN ACCORDANCE WITH A PHYSICAL SURVEY MADE ON THE GROUND UNDER THE SUPERVISION OF THE UNDERSIGNED.

SECTION 20 TOWNSHIP 6 SOUTH

there is in accordance with the
standards detailed below.
QUESTANT TO THE ACCURACY
OF A.D. GUEVEY AND THE APPLICABLE
FIELDS OF PRACTICE CITED IN LAC 40:XL1.

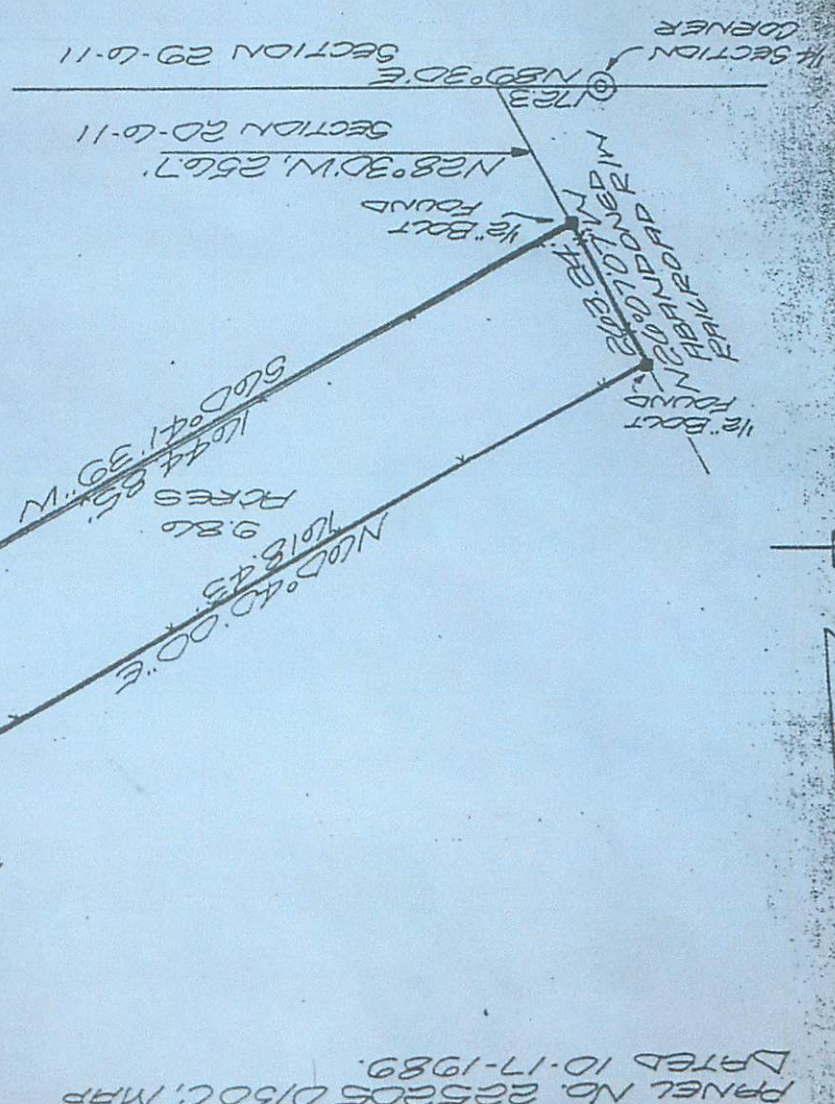

THIS PROPERTY IS LOCATED IN FOOD
ZONE C AS PER FEMA FIRM COMM.
PANEL NO. 225205 D150C, MAP
DATED 10-17-1989.