Approx. Scale 20 feet

Potential Girder

Potential Joist

Potentially Water-Logged

Potential Void
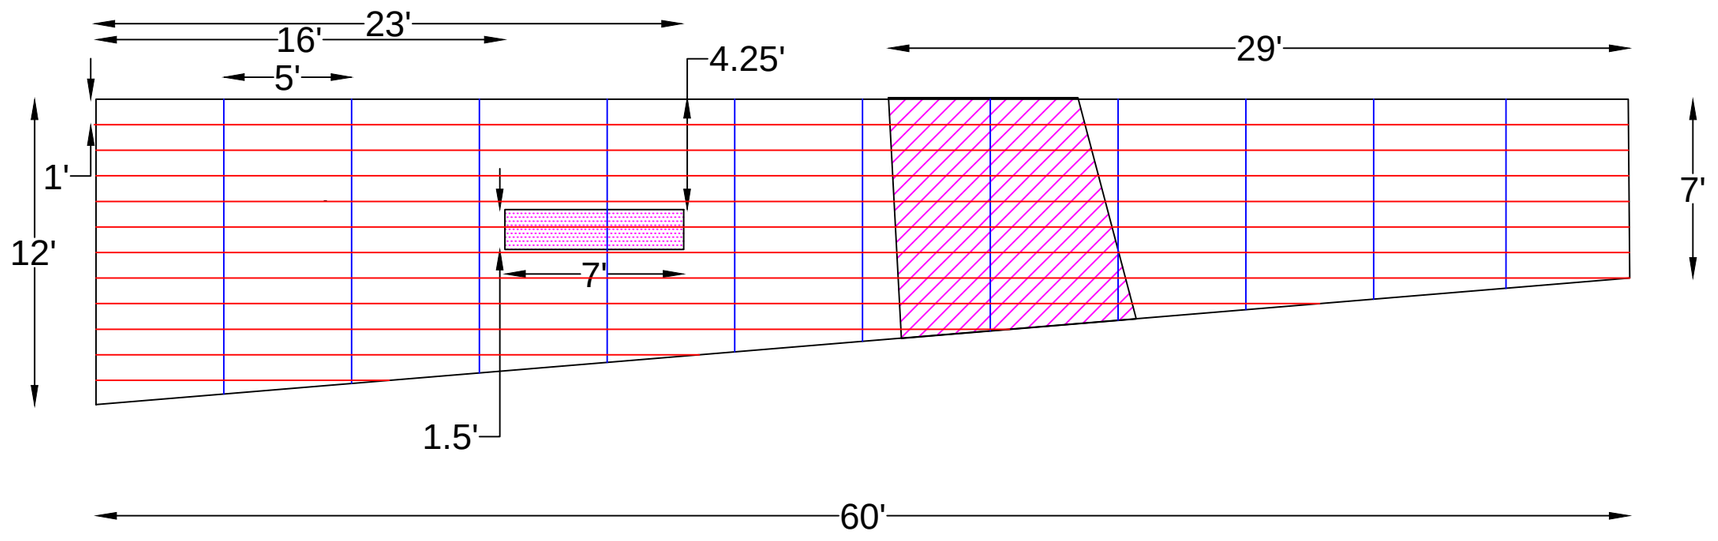
Distances shown are in feet and are from the nearest reference point.