
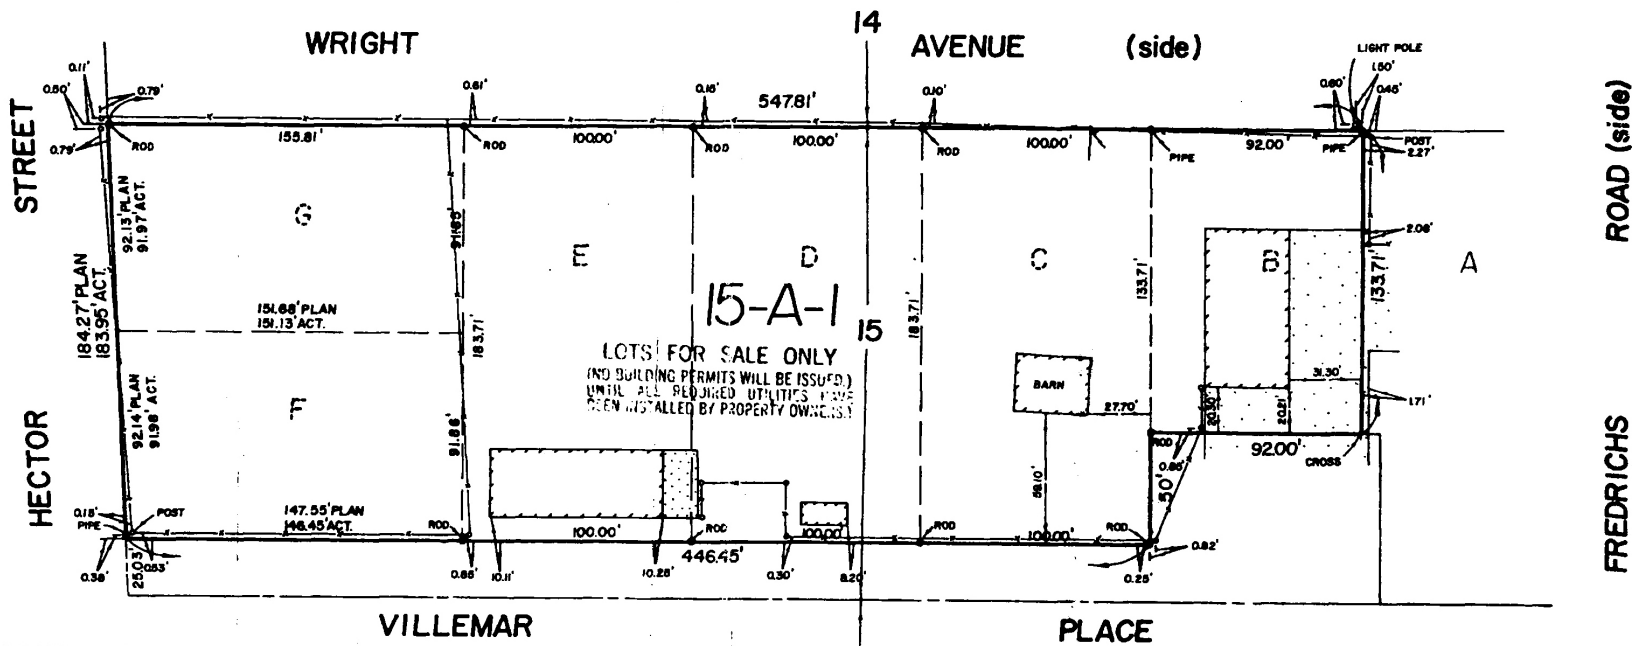


PORTION OF LOT 15
FARM BLOCK 1
OAKDALE SUBDIVISION
JEFFERSON PARISH, LOUISIANA

NOTE :
THERE IS A POWER LINE AND A BURIED TELEPHONE
LINE NEAR THE EAST PROPERTY LINE WHICH INDICATES
A SERVITUDE MAY EXIST.

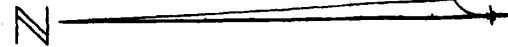

PLANNING DEPARTMENT RECOMMENDATION
APPROVAL ~~DENTAL~~

DIRECTOR OF PLANNING DEPARTMENT
DATE 8/31/83 DOCKET NO.

VILLEMAR

COUNCIL APPROVAL
DATE 8/24/83 ORDINANCE 15683


CHAIRMAN OF PARISH COUNCIL

DATE 9/1/83

HARVEY, LA MARCH 14, 1983
RESUBDIVISION OF LOTS B,C,D,E,F and G INTO
LOT 15-A. CERTIFIED CORRECT TO DR.H.J. VILLEMARETTE.

WILTON J. DUFRENE

LAND SURVEYOR!

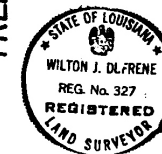

—X— = CHAIN LINK FENCE
SCALE: 1" = 40'

T-719-55