

DOOR SCHEDULE			
MARK	WIDTH	HEIGHT	DOOR TYPE
101	3' - 0"	7' - 0"	FULL LITE WOOD DOOR WITH TEMPERED GLASS
102	2' - 10"	7' - 0"	SOLID CORE FLUSH DOOR

CONFIRM ALL DOOR SIZES WITH EXISTING CONDITIONS


PLUMBING FIXTURES

- WC:** AMERICAN STANDARD
Cadet Elongated Pressure-Assisted Toilet
1.6 gpf/6.0 Lpf
- LAVATORY:** TOTO Supreme Wall Mount Lavatory
LHT241G
- FAUCET:** DELTA Commercial Electronic Lavatory Faucet
590LF-LGHGMHDF
- HANDSINK:** REGENCY
20-Gauge Type 304 SS Bowl
600HS12
- MOP SINK:** REGENCY
16-Gauge Type 304 SS Bowl
600SM162012
- MOP FAUCET:** T&S B-0702 Single Sink Faucet with 1/2" NPT
Female Inlet, 4 Arm Handle, Blue Index, and 3/4"
Garden Hose Outlet


WALL TYPES

- W1:** PARTITION WALL
2X6 @ 16" OC
5/8" MR GYPSUM BOARD EACH SIDE

*FRAMED WALLS SUPPORTING BAR & COUNTER TO BE 2X6 STUD
WALLS @ 16" O.C. W/ DOUBLE TOP PLATES.

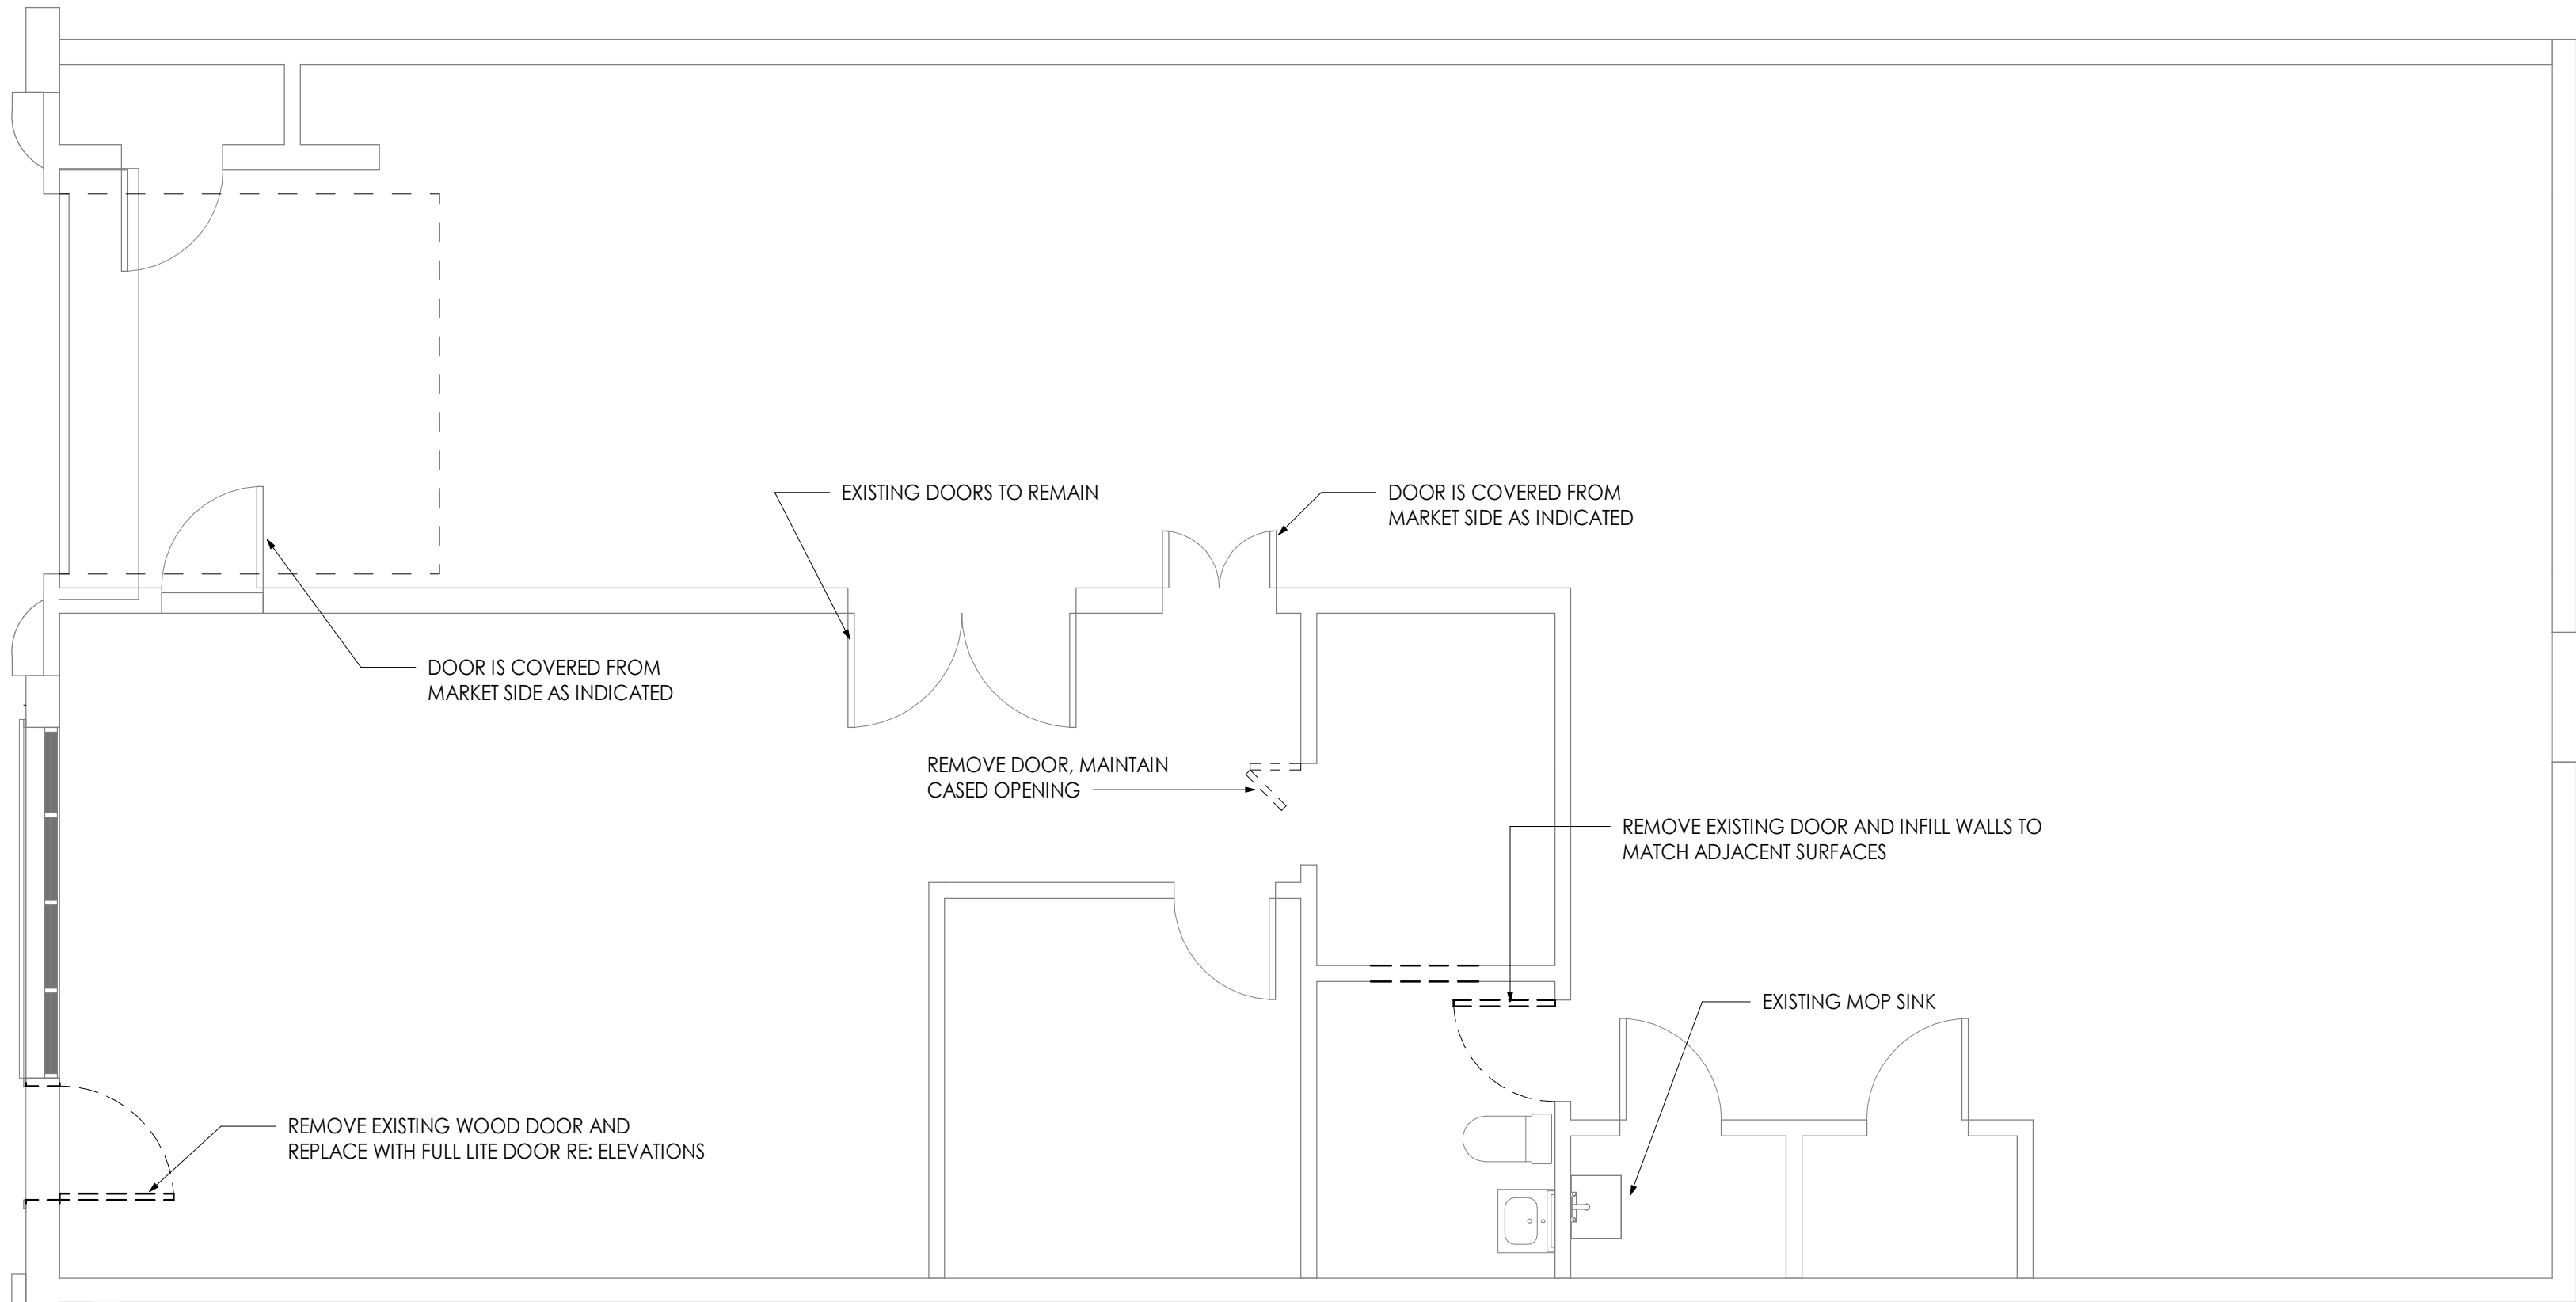


4 EXISTING FLOOR PLAN
1/4" = 1'-0"

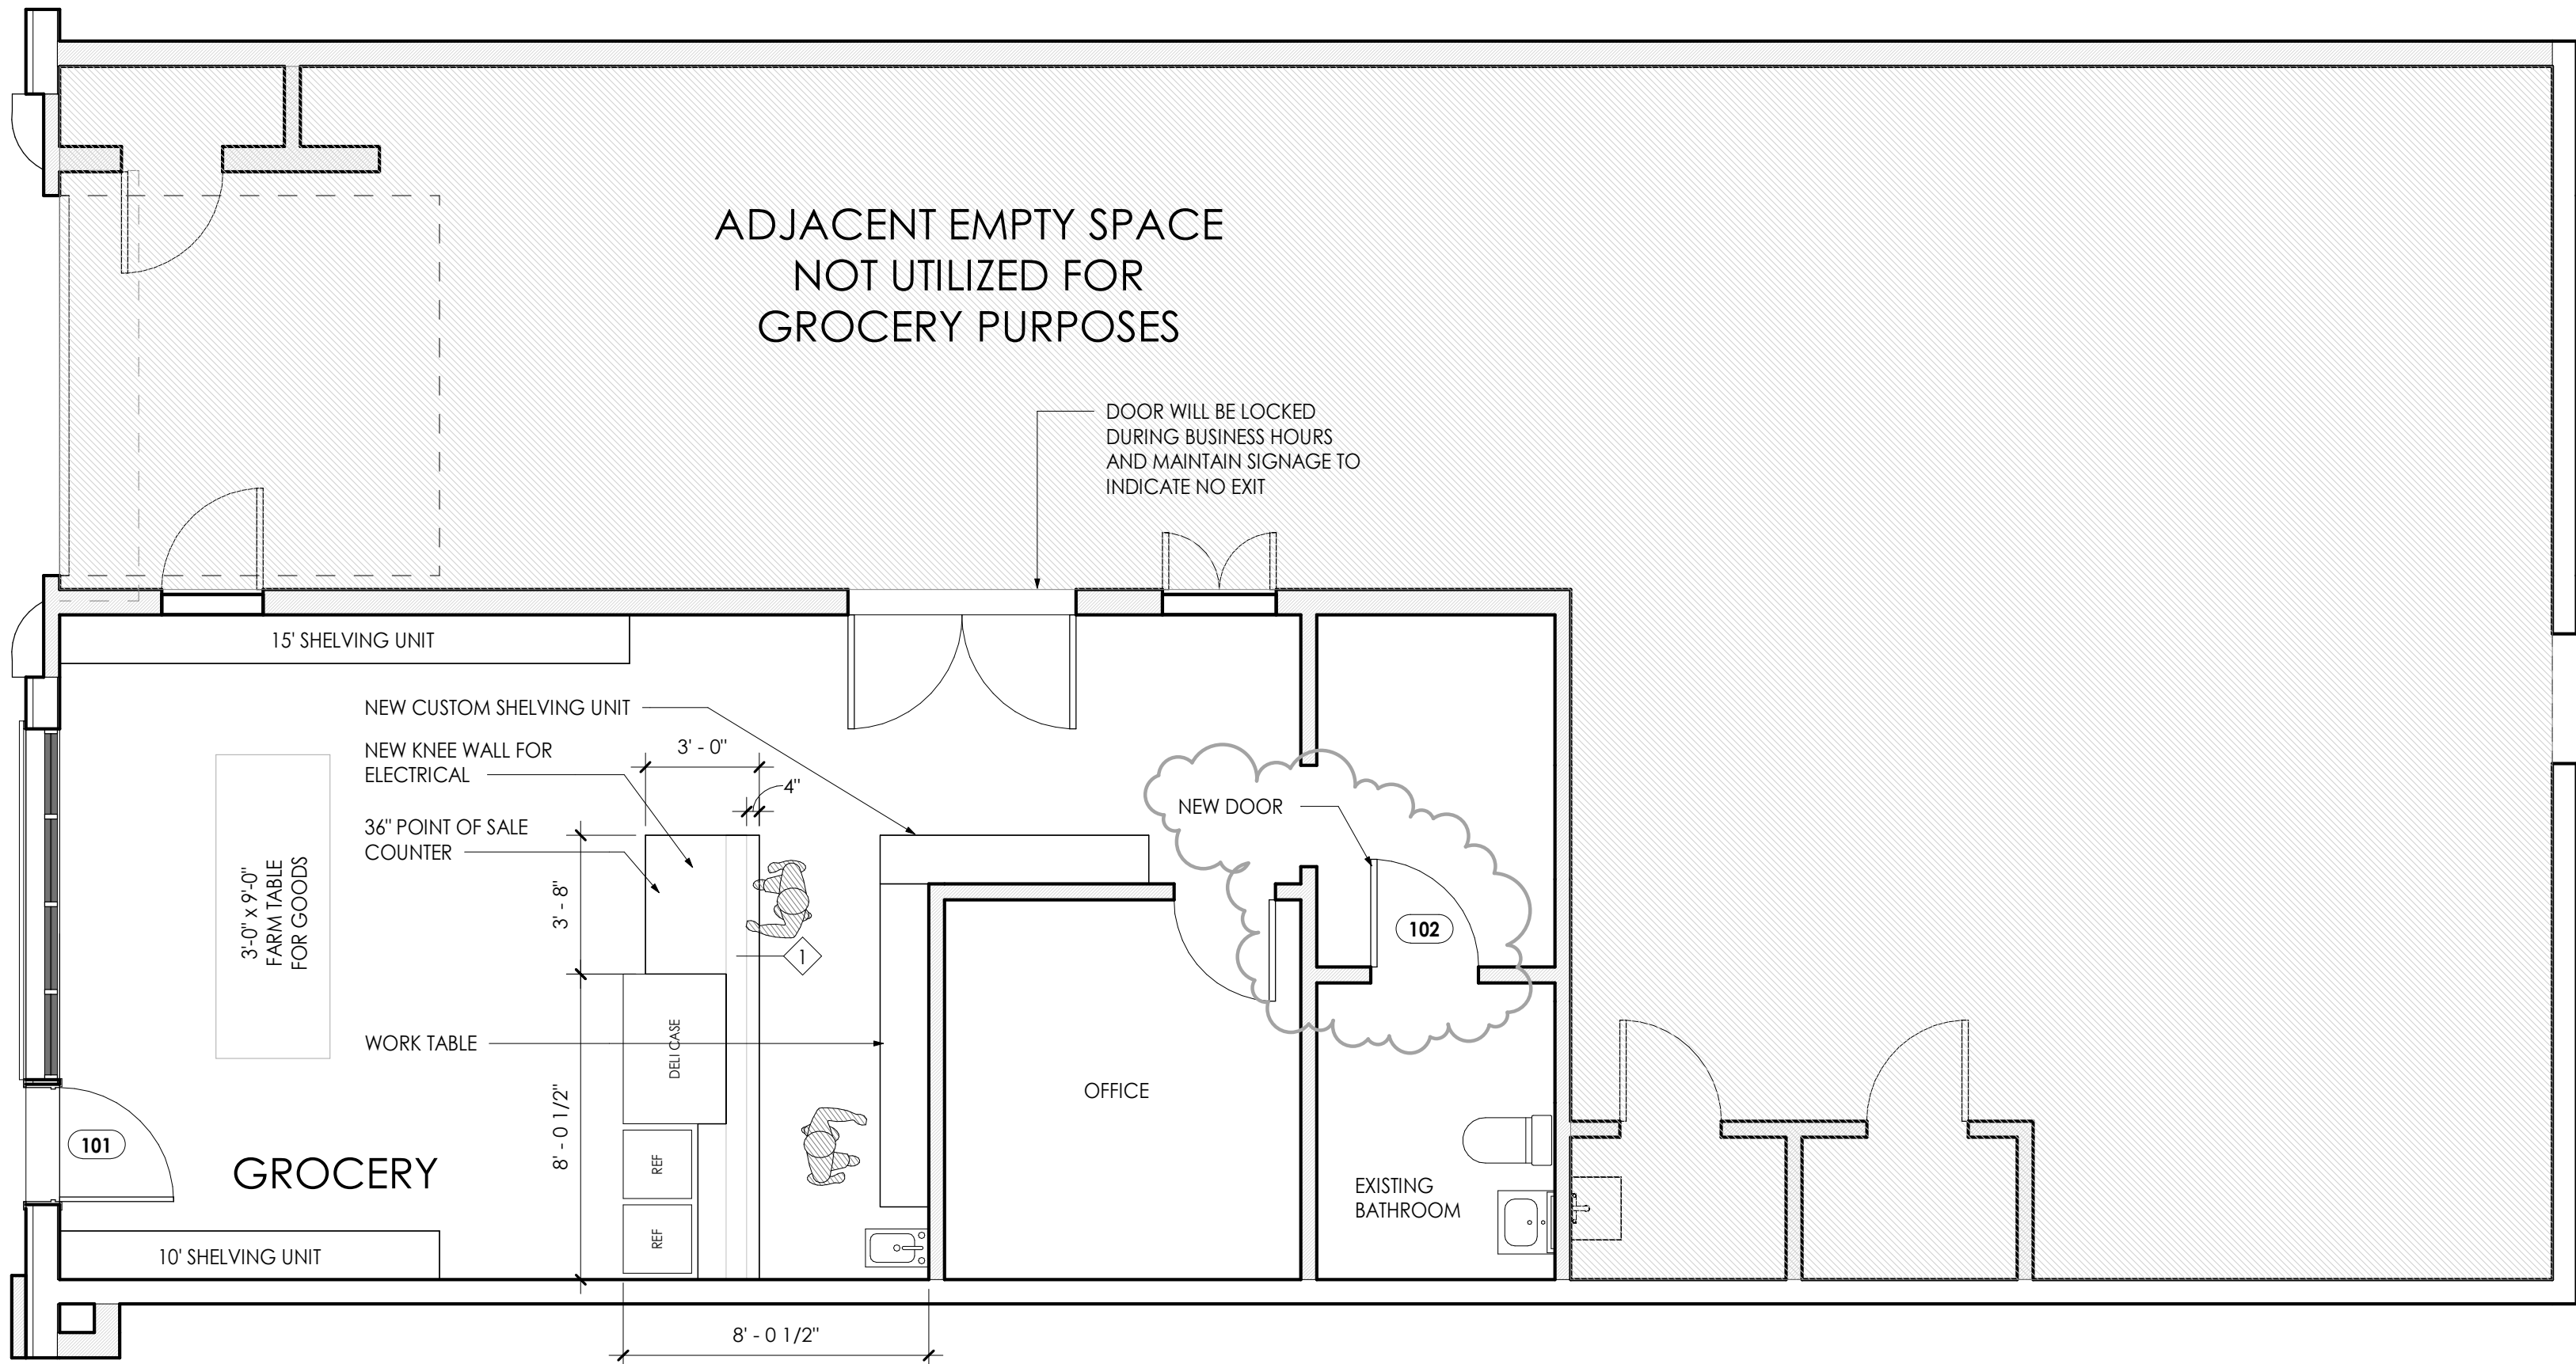

1 MARKET FLOOR PLAN
1/4" = 1'-0"

BELL BUTLER
DESIGN + ARCHITECTURE

1811 HASTINGS PLACE - SUITE B - NEW ORLEANS - LOUISIANA - 70130
info@bell-butler.com
www.bell-butler.com

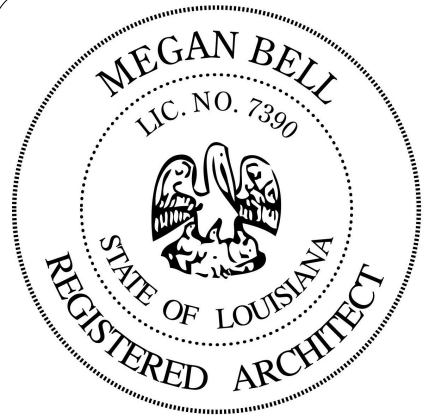

SUPERETTE

1226 Magazine Street, Unit 2 | New Orleans LA | 70130

ISSUE:

PERMIT

DATE:

05/29/2020

REVISION:

#	Description	Date
1	Revision 1	Date 1

FLOOR PLAN

A101