


EXHIBIT A

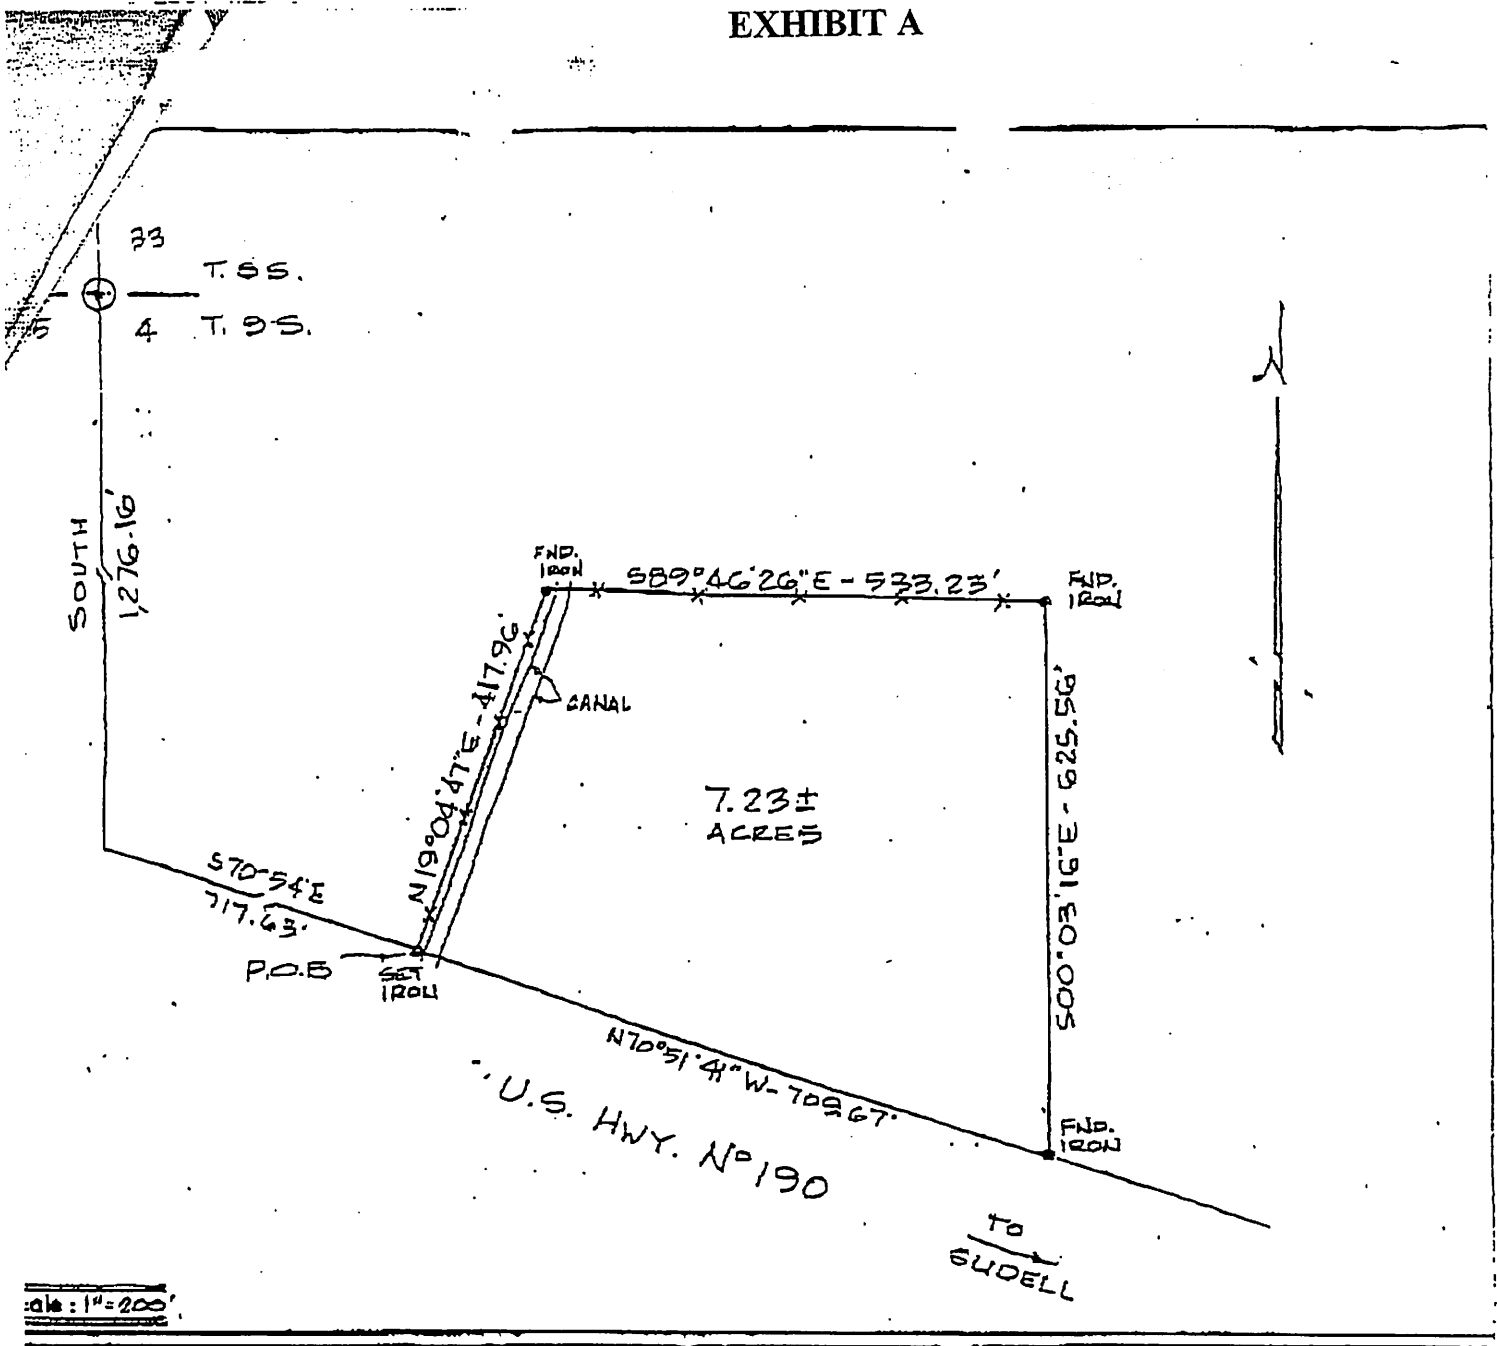

Survey Map

CERTAIN PARCEL
LAND SITUATED in SECTION 4 - T9S - R14E

in

St. Tammany Parish, Louisiana

for

BREEDING REALTY

Survey Number: 88,976
Date: APRIL 26, 1984
Revision:

This Survey is Certified
True and Correct by

Ivan M. Borgen
No. 686

