







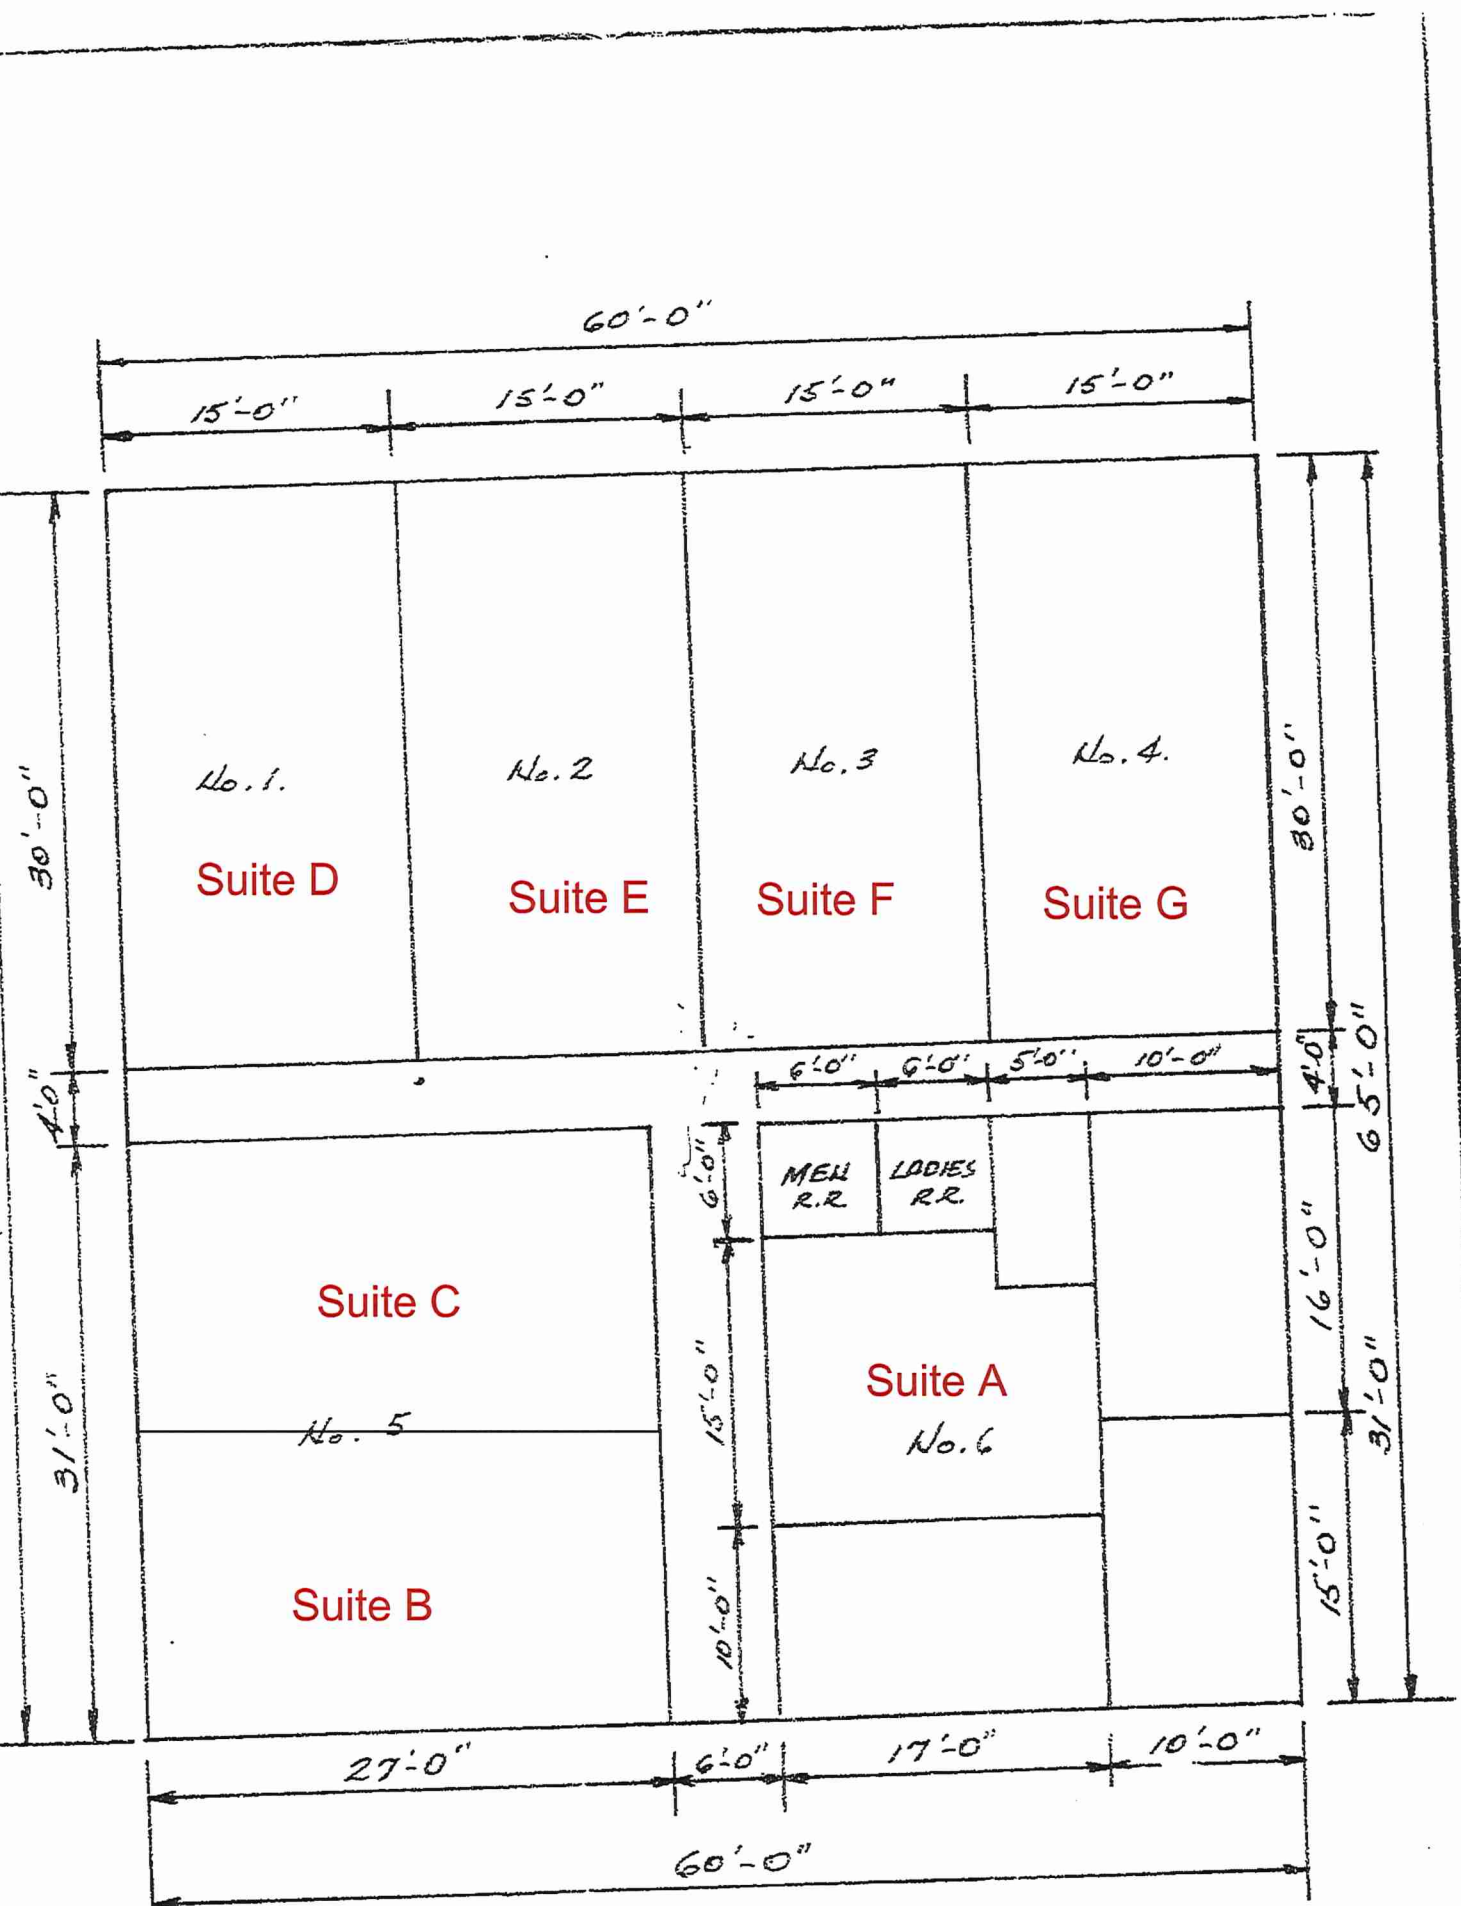

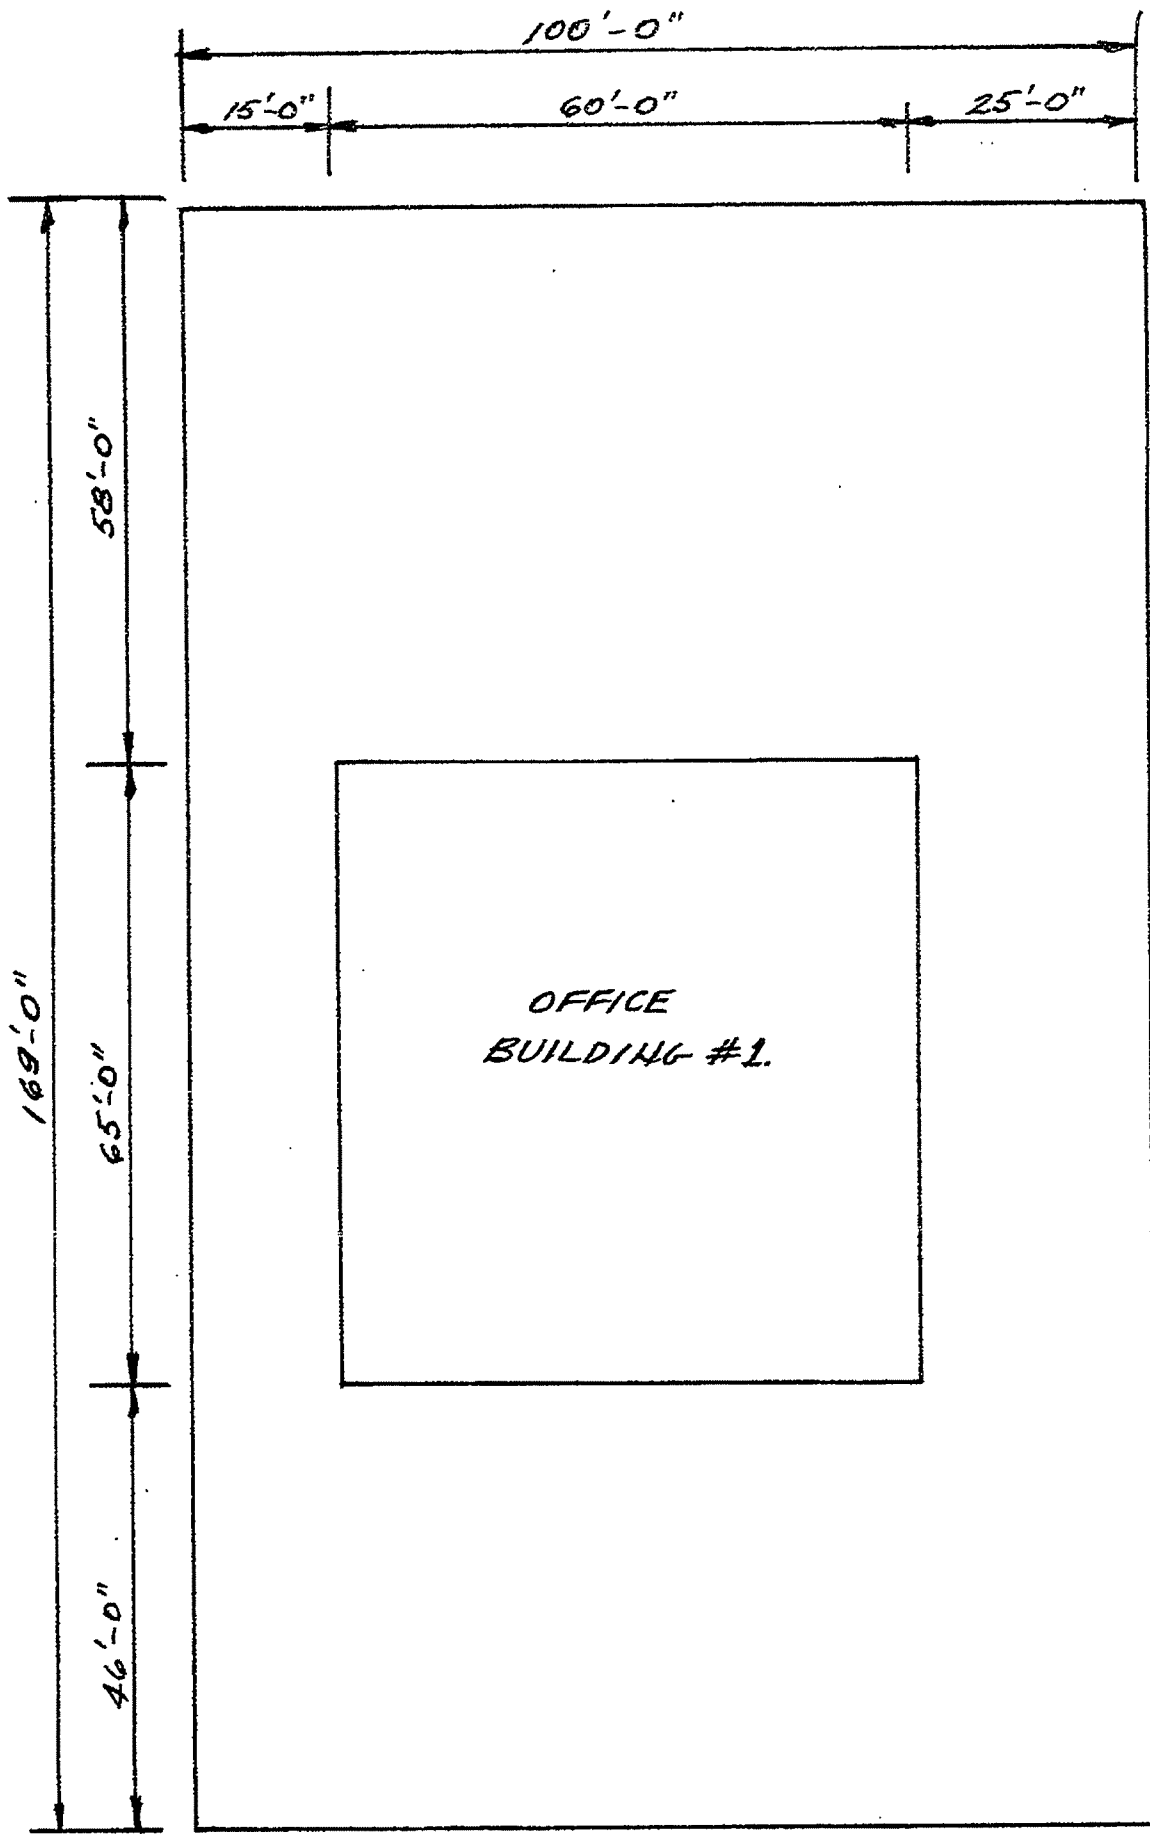

PLAN VIEW