


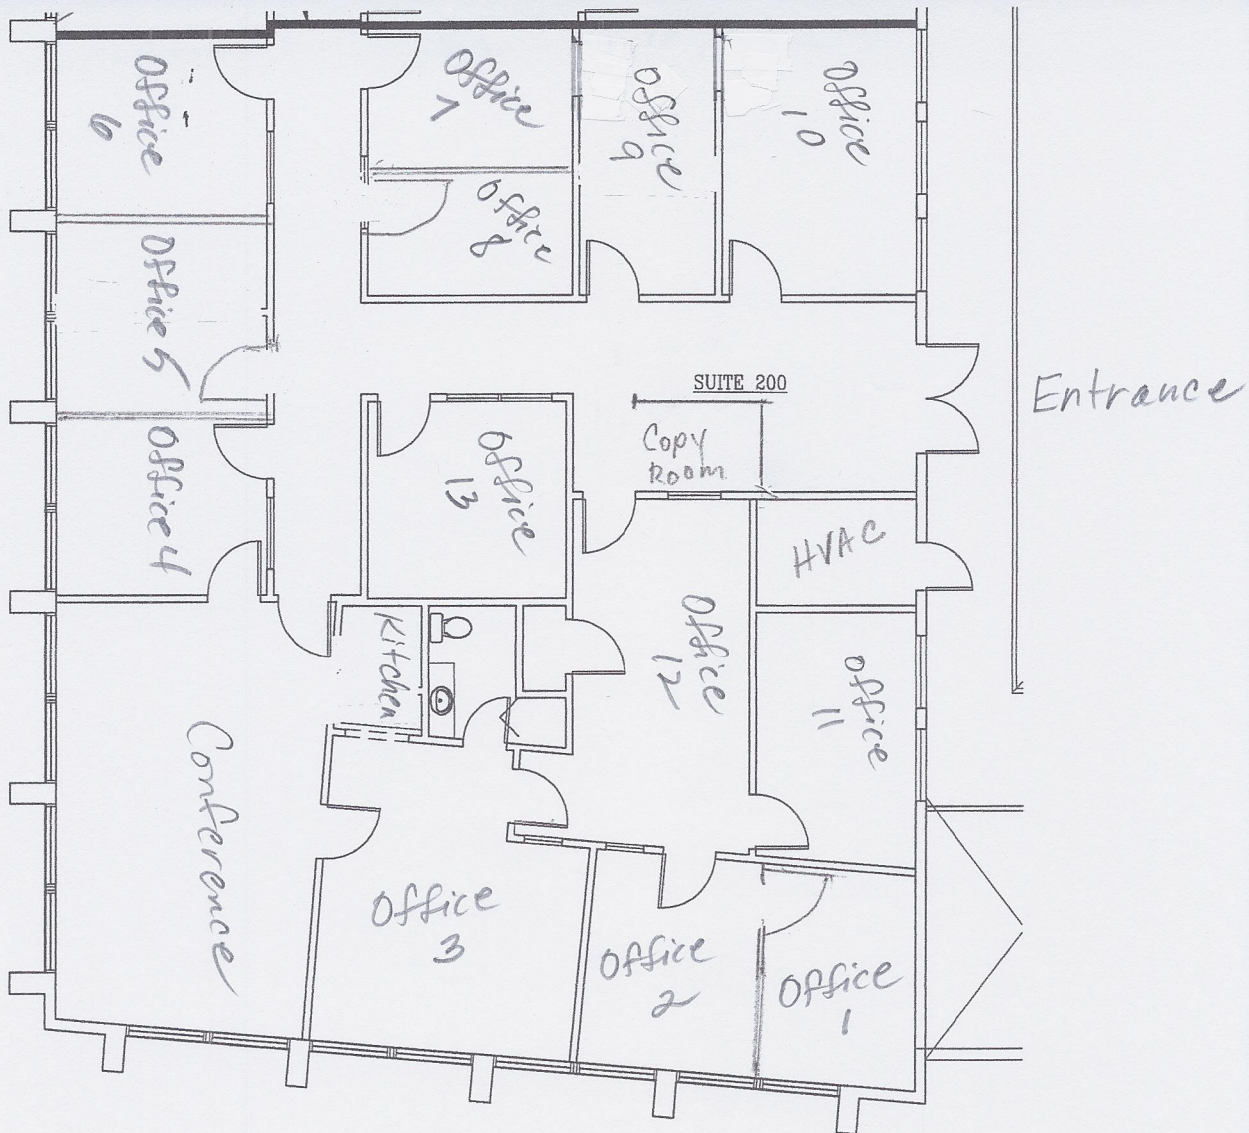



1 SUITES 200 & 203 FLOOR PLANS

SCALE: 1/8"=1'-0"

SUITE 200 USABLE AREA: 2,729 SQ. FT.
 SUITE 200 RENTABLE AREA: 3,138 SQ. FT.

SUITE 203 USABLE AREA: 1,602 SQ. FT.
 SUITE 203 RENTABLE AREA: 1,842 SQ. FT.

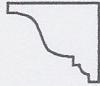SCALE: AS SHOWN	FILE NAME: 09012\2NDFLEplan04.C
DATE: 22 June 2016	
 STEVEN J. FINEGAN ARCHITECTS, LTD. A PROFESSIONAL CORPORATION 123 S. PIERCE ST. NEW ORLEANS, LA. 70119 (504) 486-5744 E-MAIL: fineganstevenjar@bellsouth.net	
SUITES 200 & 203 824 ELMWOOD PARKWAY 2ND FLOOR	SHEET NO. OF SHEETS A1
This drawing is the property of STEVEN J. FINEGAN ARCHITECTS, LTD. It is not to be reproduced, copied or altered in whole or in part. It is not to be used for any purpose without the approval of STEVEN J. FINEGAN ARCHITECTS, LTD. and is to be returned on request.	

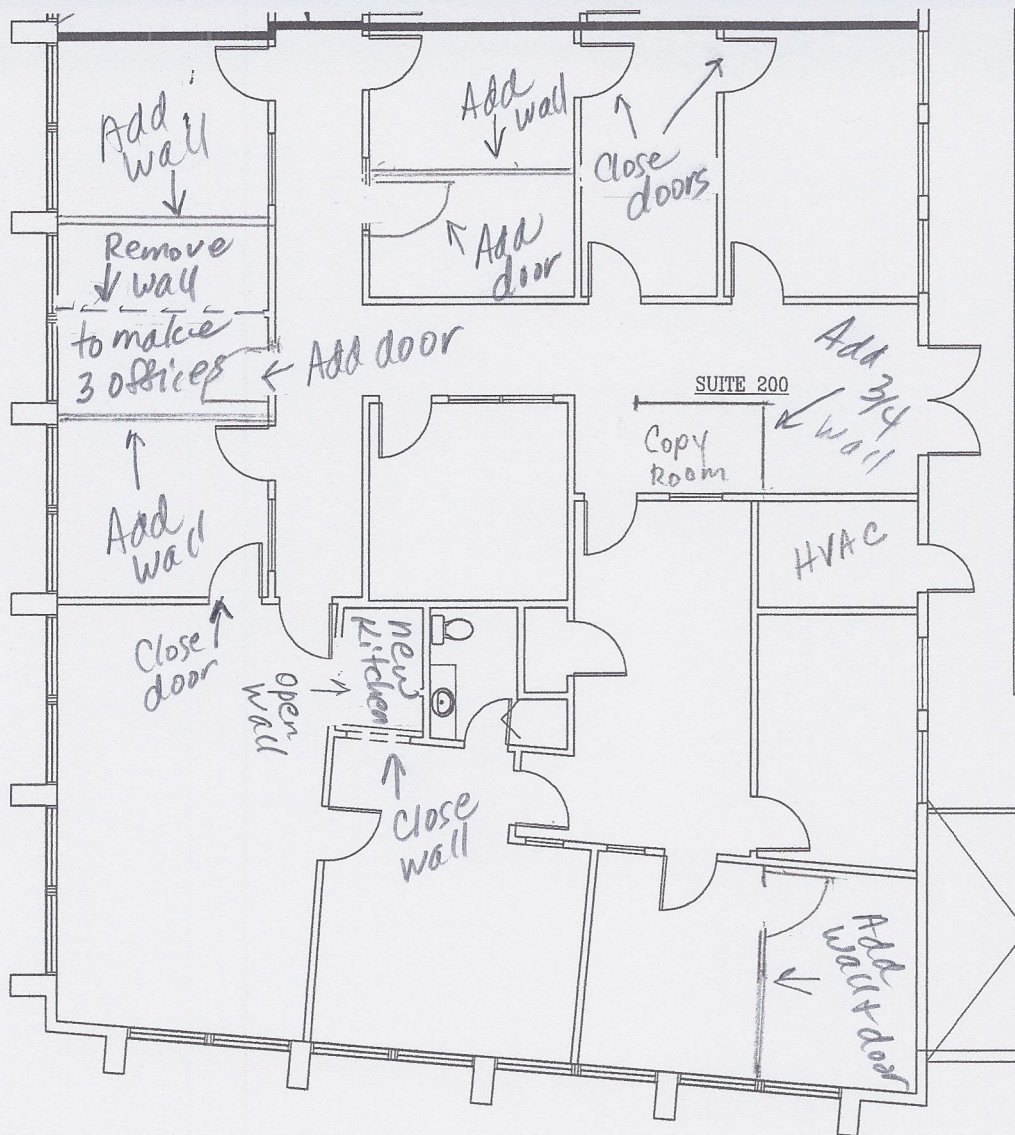


1 SUITES 200 & 203 FLOOR PLANS

SCALE: 1/8"=1'-0"

SUITE 200 USABLE AREA: 2,729 SQ. FT.
 SUITE 200 RENTABLE AREA: 3,138 SQ. FT.

SUITE 203 USABLE AREA: 1,602 SQ. FT.
 SUITE 203 RENTABLE AREA: 1,842 SQ. FT.

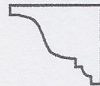SCALE: AS SHOWN	FILE NAME: 09012\2NDFLRplan04.C
DATE: 22 June 2016	
 STEVEN J. FINEGAN ARCHITECTS, LTD. A PROFESSIONAL CORPORATION 123 S. PIERCE ST. NEW ORLEANS, LA. 70119 (504) 486-5744 E-MAIL: fineganstevenjar@bellsouth.net	
SUITES 200 & 203 824 ELMWOOD PARKWAY 2ND FLOOR	SHEET NO. OF SHEETS A1
This drawing is the property of STEVEN J. FINEGAN ARCHITECTS, LTD. It is not to be reproduced, copied or altered in whole or in part. It is not to be used for any purpose without the approval of STEVEN J. FINEGAN ARCHITECTS, LTD. and is to be returned on request.	