


4,308 SQ. FT. RENTABLE

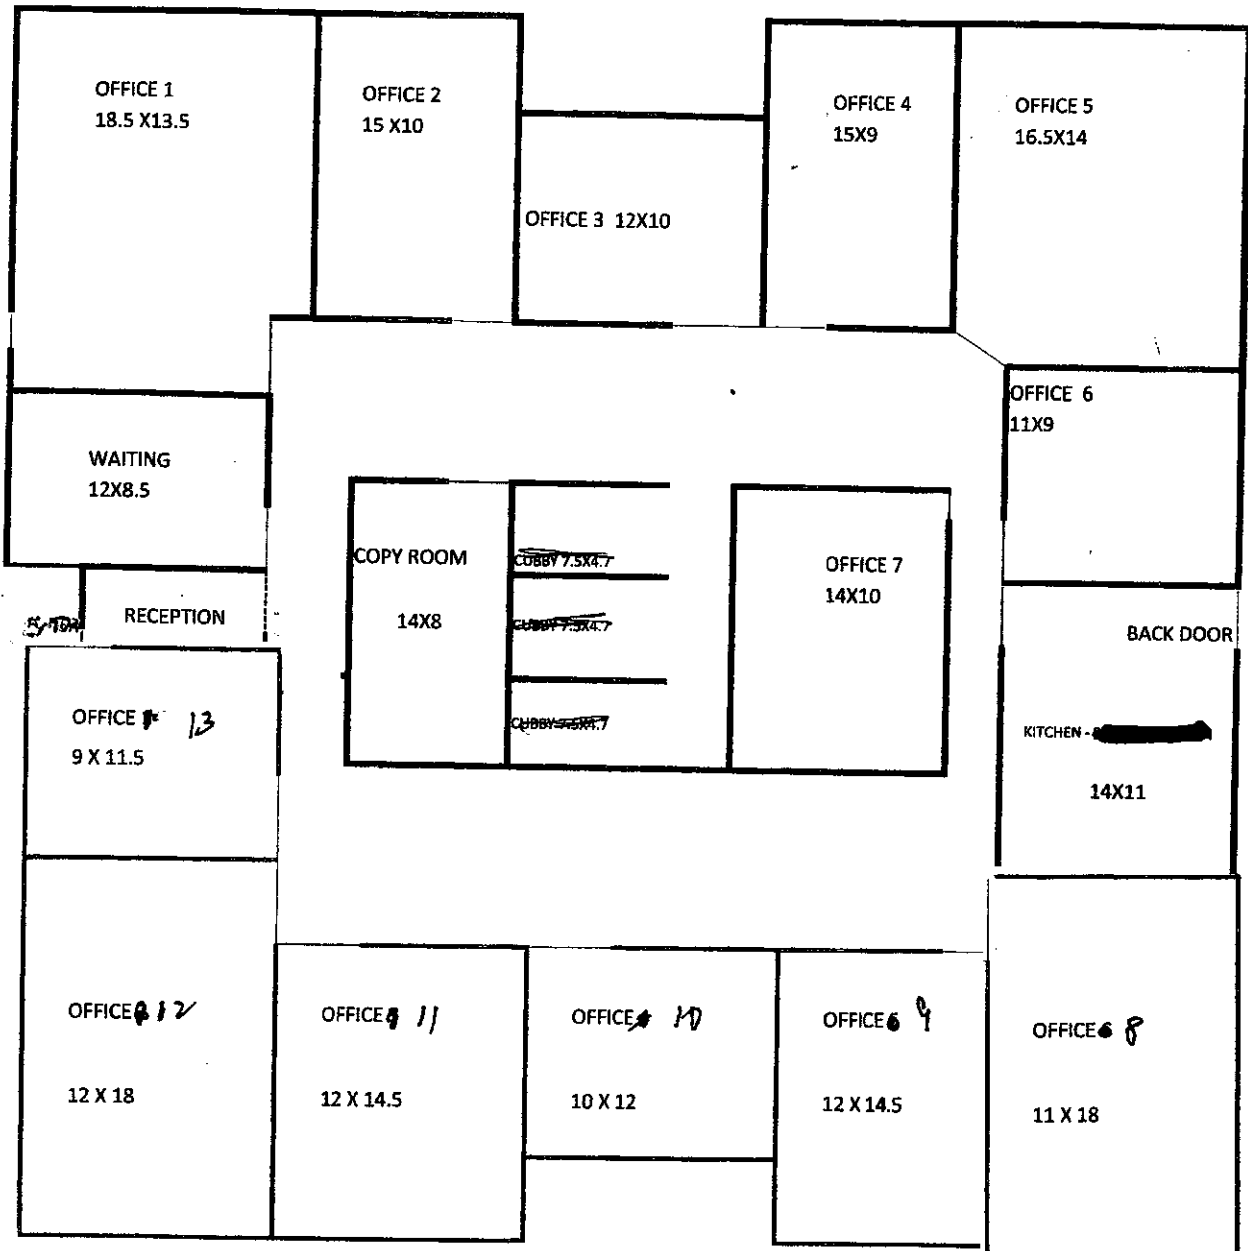

DIMENSIONS ARE APPROXIMATE - SHOWN IN FEET