



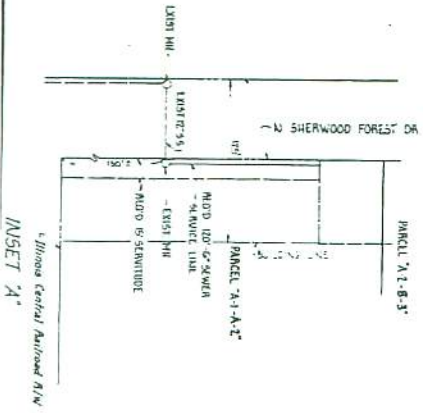

NOTE: THIS IS AN EXCHANGE OF PROPERTY AND ADDITIONAL LOTS ARE BEING CREATED.


200000 141





APPROVED
PLANNING COMMISSION
CITY OF BATON ROUGE
PARISH OF EAST BATON ROUGE

DATE: 8/4/82

EXCHANGE OF PROPERTY COMBINING PARCEL A-1-A & A-2-A TO CREATE PARCEL A-1-A-C; AND COMBINING PARCEL A-1-B & A-2-B TO CREATE PARCEL A-1-B-C

LOCATED IN SECTION 6, T15-N, R2E AND SECTION 31, T6S-N, R2E, G.L.D. EAST BATON ROUGE PARISH, LOUISIANA (FORMER BATON ROUGE AIR FORCE STATION PROPERTY)

INDUSTRIAL SQUARE OF BATON ROUGE, INC.
2620 N. SHERWOOD FOREST DR.
BATON ROUGE, LA 70815

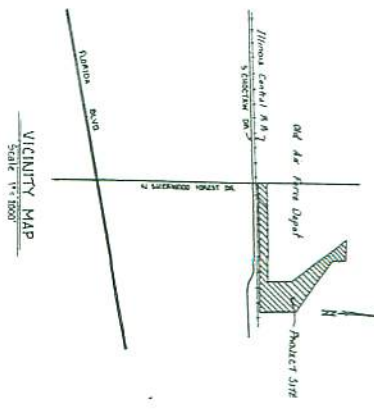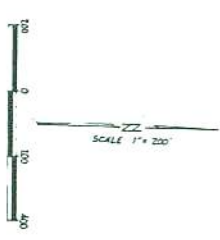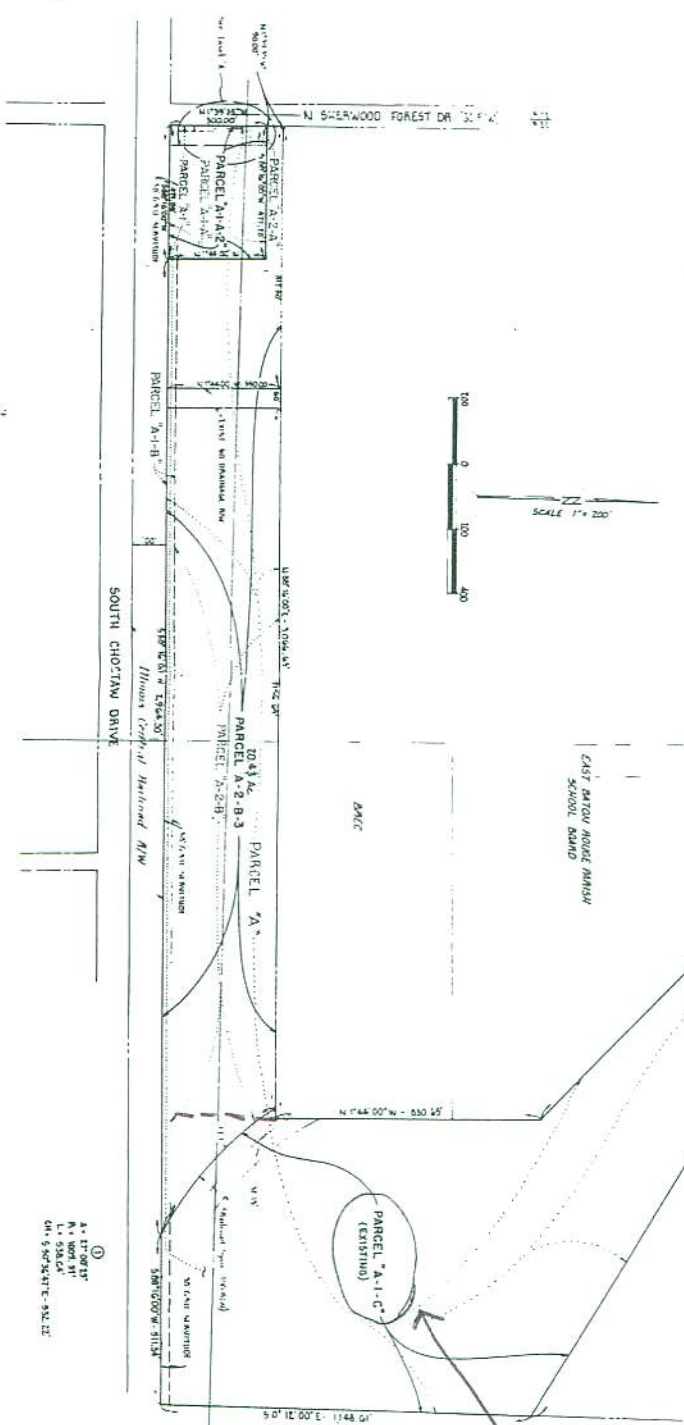

Site
70 Acres
Zone P-1