


# BENCHMARK (TBM)

T.B.M. - "X" CHIP IN NORTHEAST CORNER OF CONCRETE SLAB OF TRANSFORMER @ NORTHEAST CORNER OF PROPERTY ON W. SIDE OF KALISTE SALOOM ROAD. ELEVATION - 35.81' M.S.L.

## LEGEND

- EXISTING ELEVATION

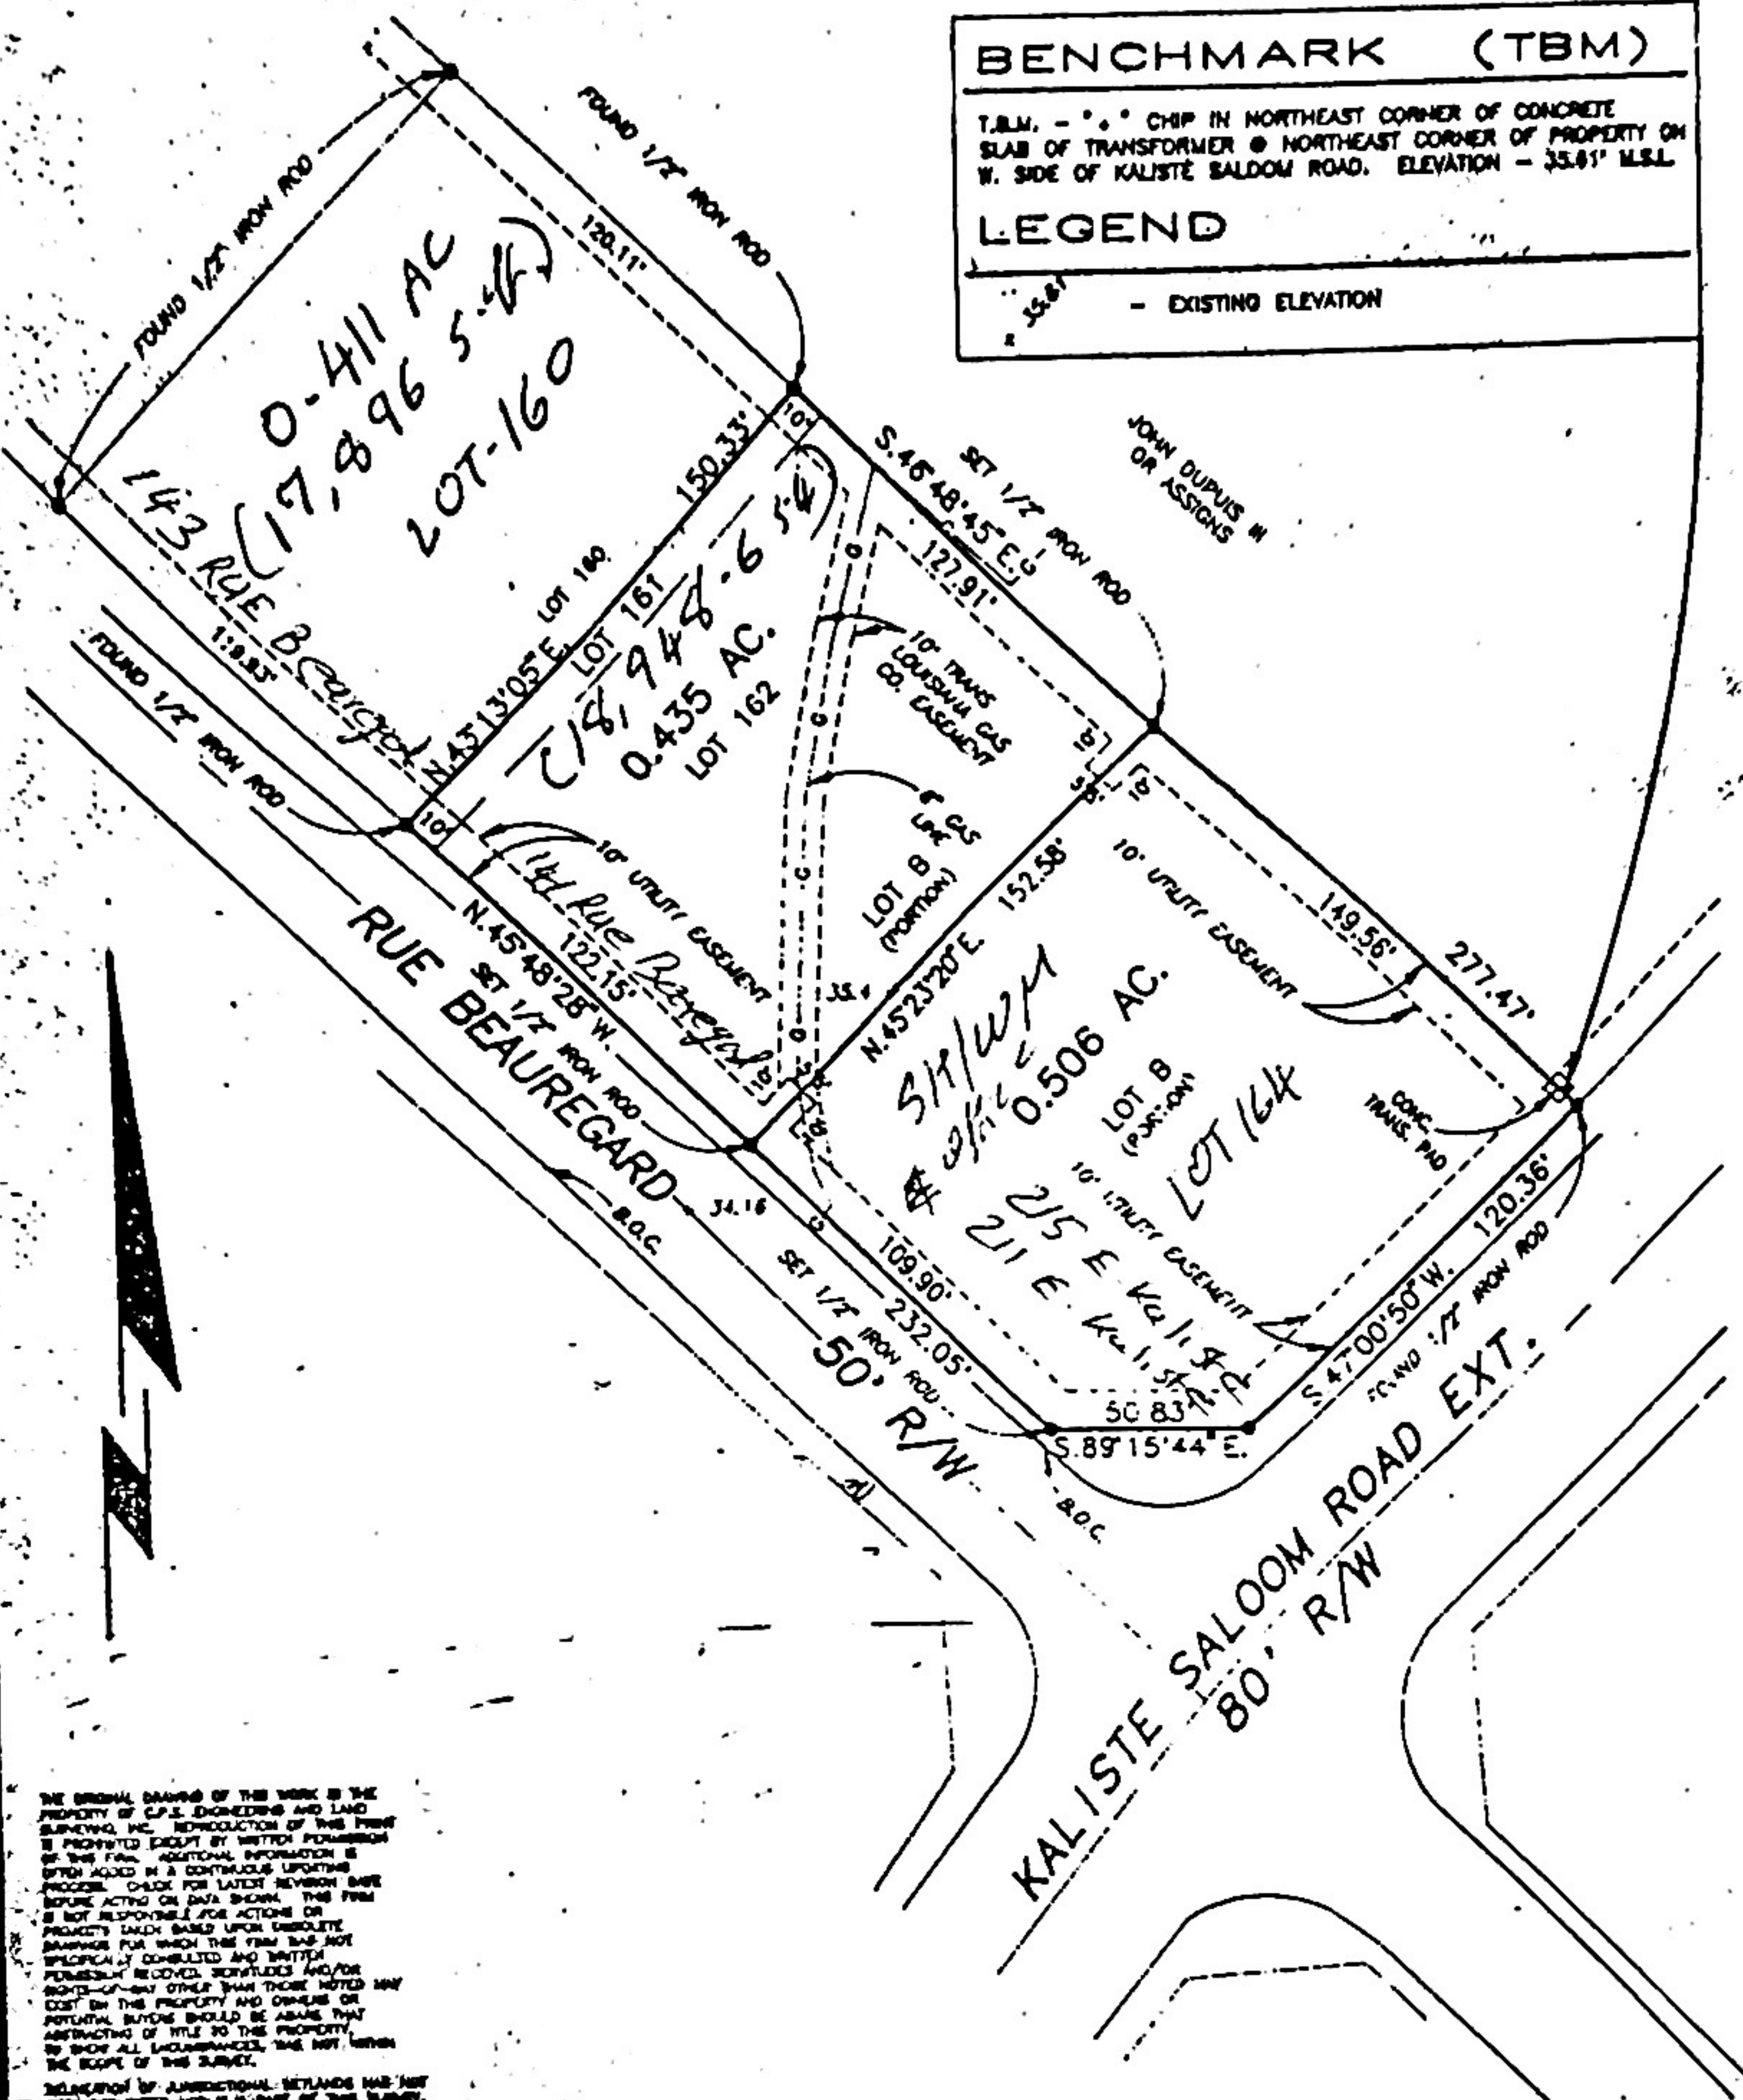

THE ORIGINAL DRAWING OF THIS WORK IS THE PROPERTY OF C.P.S. ENGINEERING AND LAND SURVEYING, INC. REPRODUCTION OF THIS PRINT IS PROHIBITED EXCEPT BY WRITTEN PERMISSION OF THE FIRM. ADDITIONAL INFORMATION IS BEING ADDED IN A CONTINUOUS UPDATING PROCESS. CHECK FOR LATEST REVISIONS BEFORE ACTING ON DATA SHOWN. THIS FIRM IS NOT RESPONSIBLE FOR ACTIONS OR PROJECTS TAKEN BASED UPON DISCREPANCIES BETWEEN THE DATA SHOWN HEREIN AND THE ACTUAL FIELD CONDITIONS. THE FIRM HAS NOT BEEN ADVISED OF ANY CHANGES OR DISCREPANCIES SINCE THE DATE OF THE SURVEY. 

"I HEREBY CERTIFY THAT THE ABOVE PLATTED PROPERTY IS LOCATED IN FLOOD ZONE C, AS SHOWN ON THE FIRM MAP COMMUNITY PANEL #220105 0015E, DATED JULY 3, 1985, WHICH IS THE CLASSIFICATION FOR PROPERTY LOCATED ABOVE THE 100 YEAR FLOOD PLAIN."

"I HEREBY CERTIFY THAT THIS PLAT REPRESENTS AN ACTUAL GROUND SURVEY AND THAT NO ENCROACHMENTS EXIST EITHER WAY ACROSS ANY OF THE PROPERTY LINES, EXCEPT AS SHOWN."

PLAT OF SURVEY SHOWING  
PROPERTY TO BE ACQUIRED BY

**ANIL SHAH AND  
SANGEETA SHAH**

LOCATED IN SECTION 46, T 10 S - R 4 E, BEING LOT 161, LOT 162, AND A PORTION OF LOT B, VERMILION SQUARE, CORNER OF KALISTE SALOOM ROAD EXT. AND RUE BEAUREGARD, CITY OF LAFAYETTE, LAFAYETTE PARISH, LOUISIANA.

SURVEYED BY:  
EDMOND E. DUPRE, JR., INC.

Edmond E. Dupre, Jr.

REG. No. 188

REGISTERED

EDMOND E. DUPRE, JR. - P. L. S.

LA REG. NO. 188

SCALE 1" = 60'

DECEMBER 13, 1994

