


PATHFILE: \\MK\SURVEYING\2009\Lot Survey\PINECREST 50\eq. 5\LOTS 1-4 35-39, SQ. 5, PINECREST, HIRAM INVESTMENTS, 20090597.dwg, 20090597.dwg

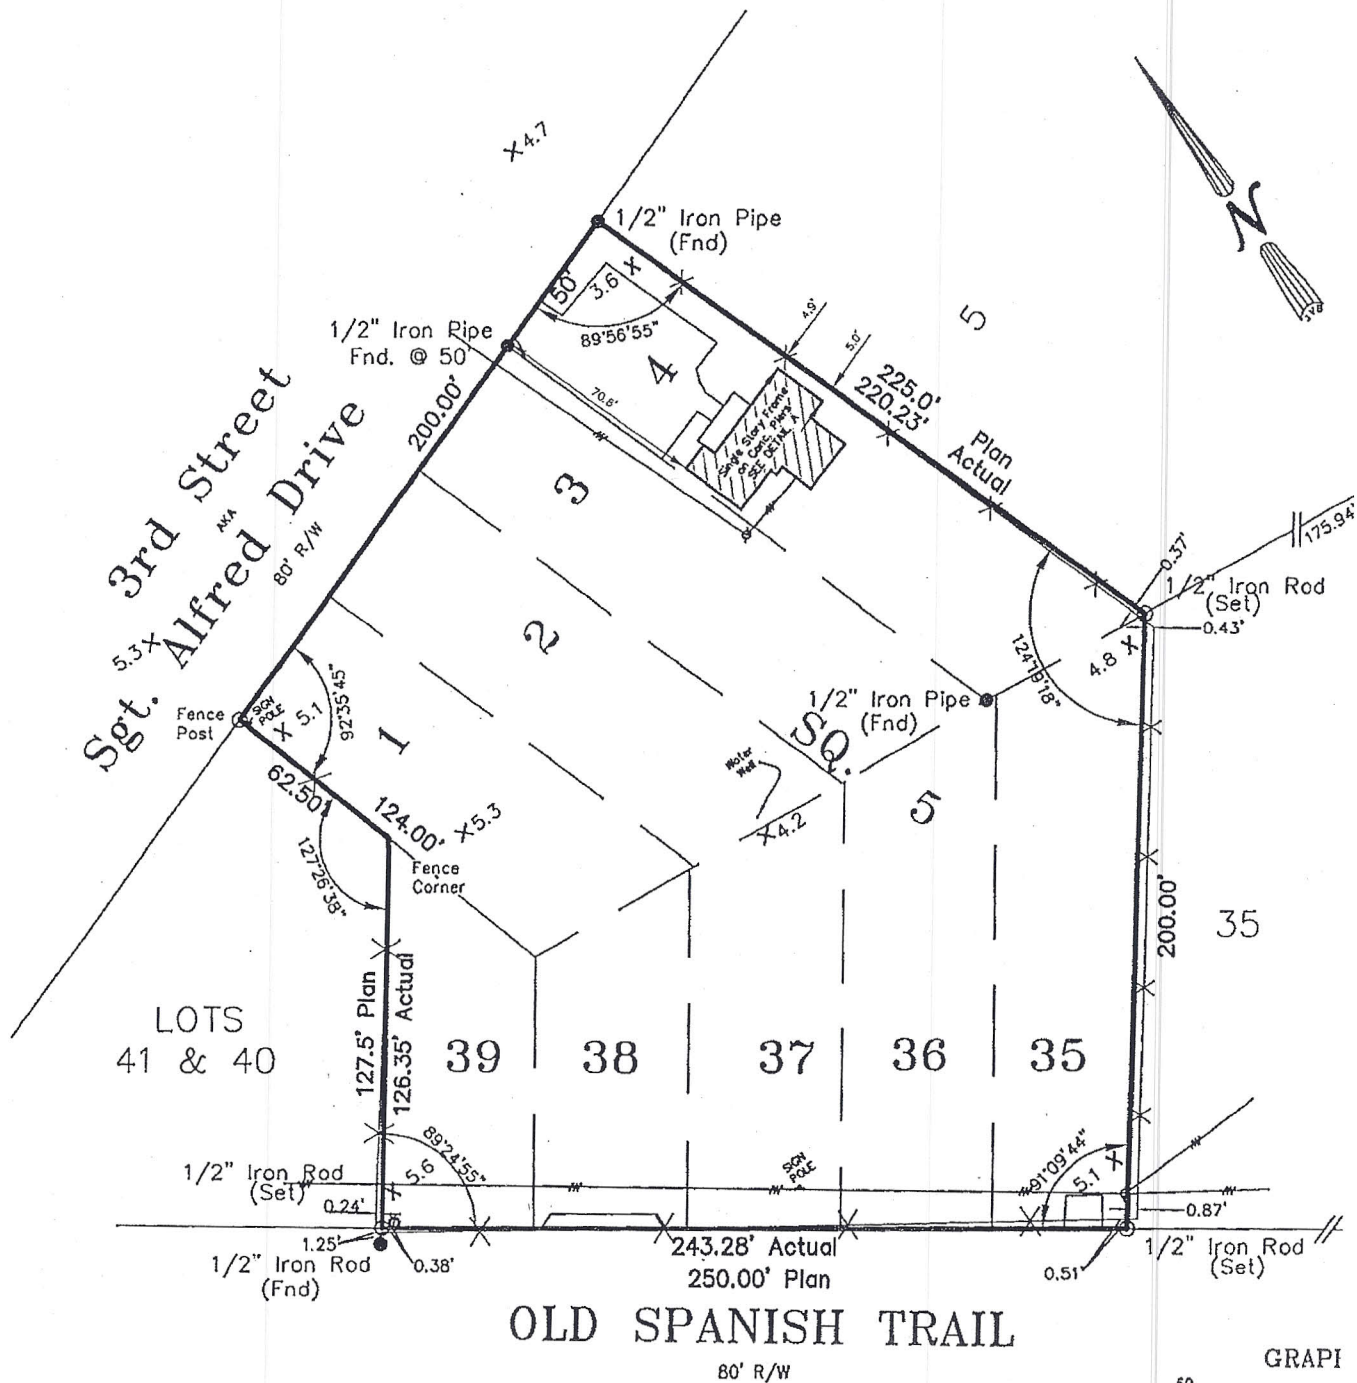

SCALE: 1" = 60'

DATE: 5/29/2009

DRAWN BY: DLT CHECKED BY: JDL

DWG. NO: 20090597

SHEET 1 OF 1

I certify that this plot does represent an actual ground survey and that to the best of my knowledge no encroachments exist either way across any of the property lines, except as shown. Encumbrances shown hereon are not necessarily exclusive. Encumbrances of record as shown on title opinion or title policy will be added hereto upon request, as surveyor has not performed any title search or abstract.

I have consulted the Flood Insurance Rate Maps and found this property is in a Special Flood Hazard Area.

F.I.R.M.: 220204 0010 C  
DATE: 4/21/1999  
ZONE: AE  
B.F.E. = 9.0'

\* Verify prior to construction with local governing body.

# ELEVATION SURVEY OF & LOTS 35 THRU 3 PINECREST SUE CITY OF SL ST. TAMMANY P

Declaration is made to original purchaser of the survey. It is a subsequent owners. Survey is valid only if print has original seal in accordance with the Louisiana "Minimum Standards for Property Bearings are based on record bearings unless noted otherwise.

HIRAM INVESTMEN