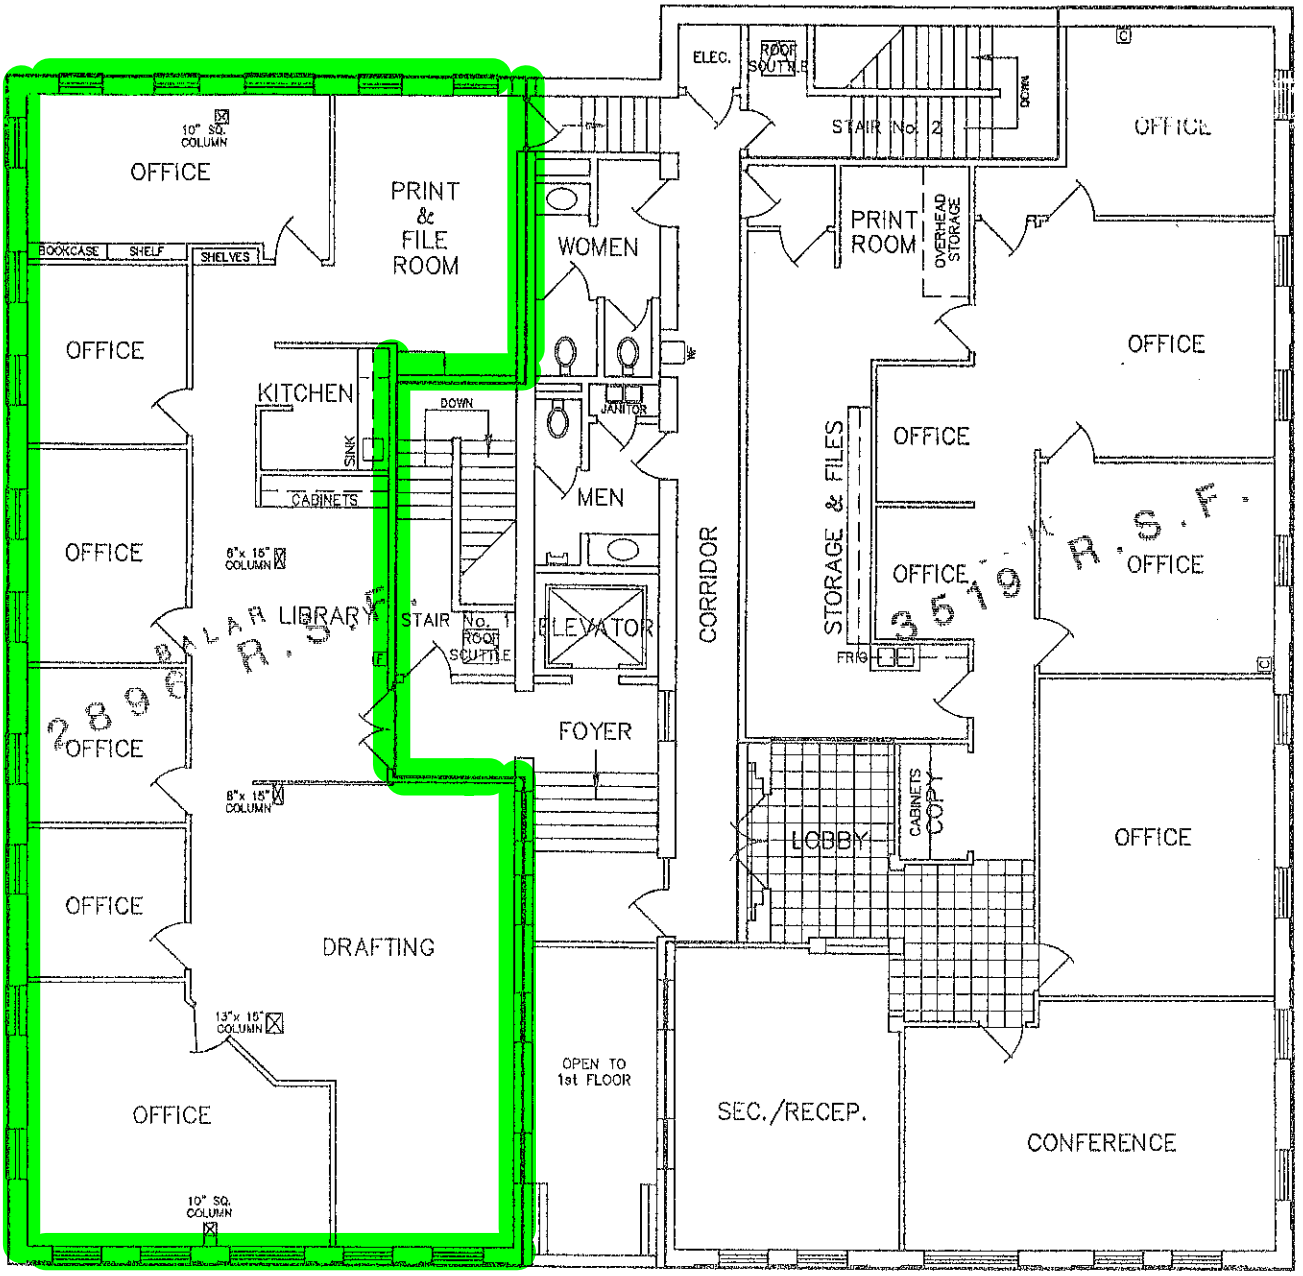

BLANCHARD BUILDING

SHEPHERD BUILDING

THIRD FLOOR RECORD DRAWING PLAN

SCALE: 1/8" = 1'-0"