


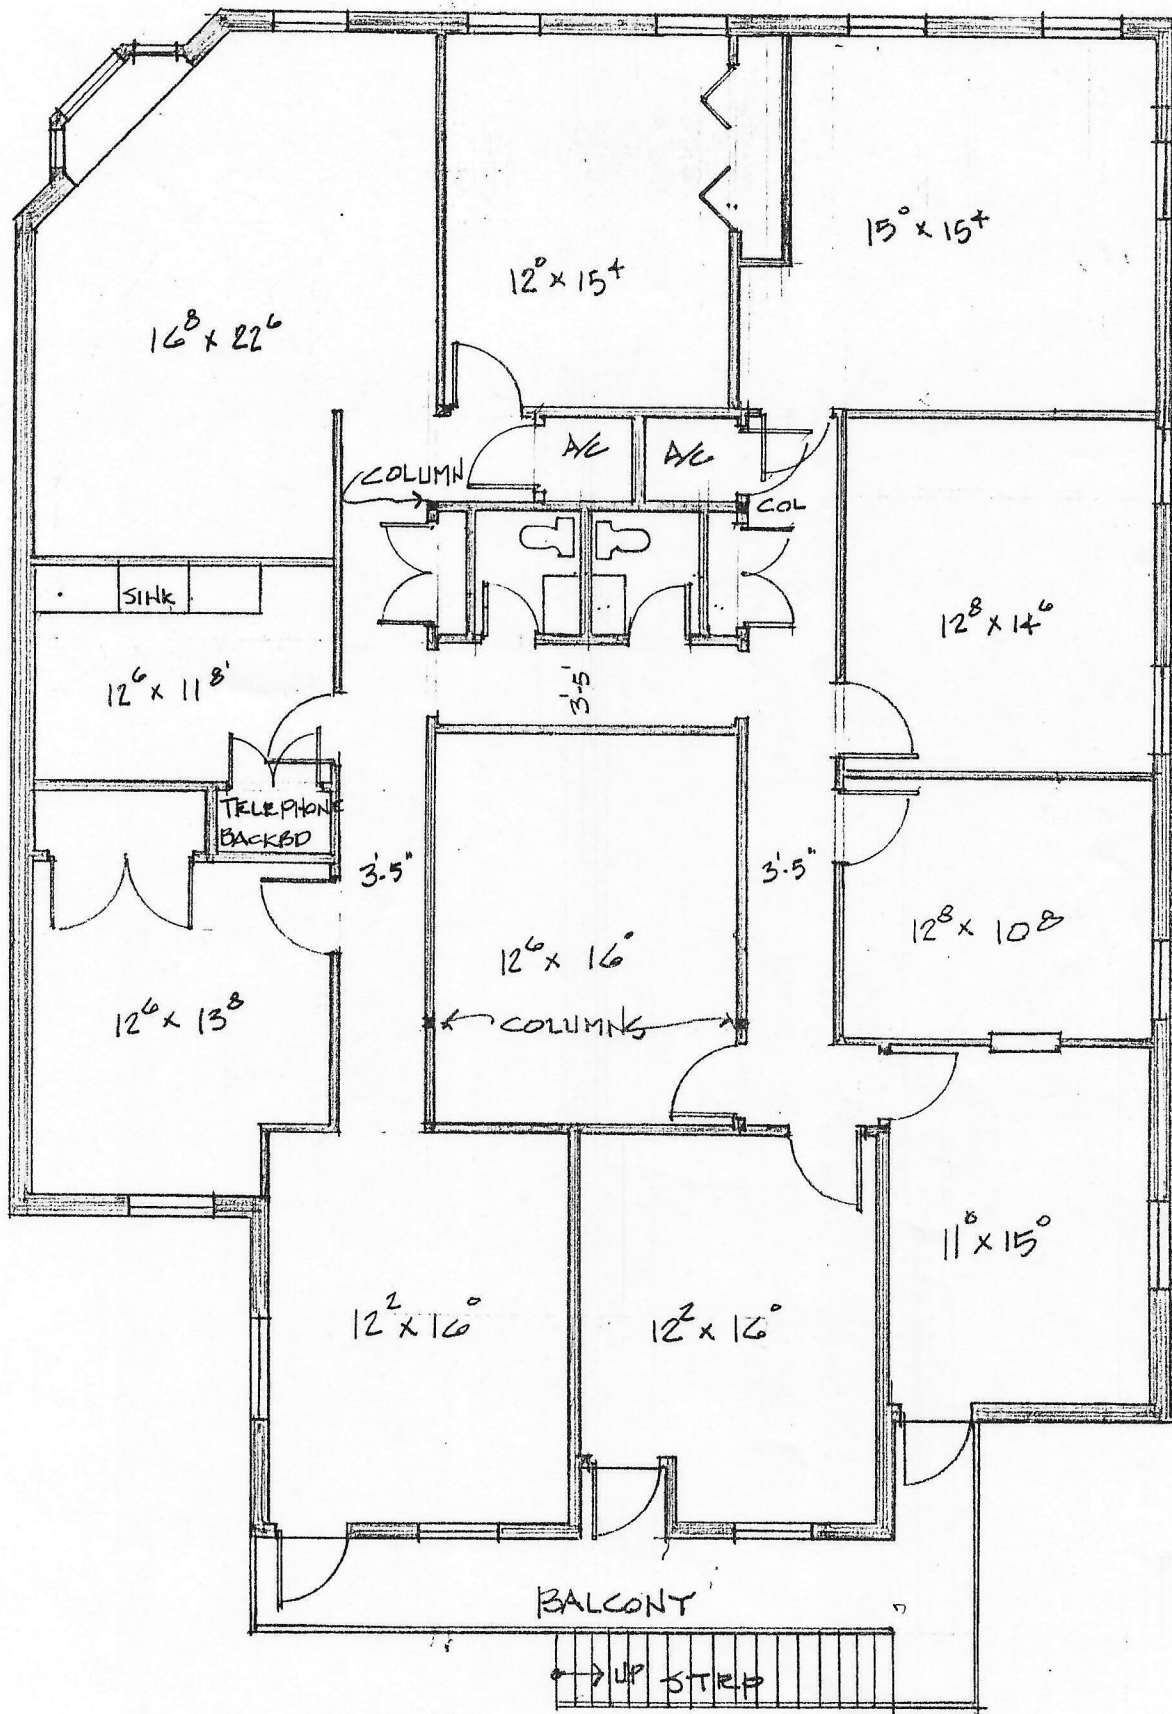

SECOND FLOOR EXISTING CONDITIONS • $\frac{1}{8}'' = 1'-0''$