


GENERAL NOTES:

NOTE: THIS SURVEY IS SUBJECT TO THOSE FACTS WHICH MIGHT BE DISCLOSED BY A COMPLETE TITLE SEARCH. CERTIFICATION DOES NOT EXTEND TO ANY OTHER PARTY NOR IS THIS PLAT TO BE COPIED OR DISTRIBUTED WITHOUT WRITTEN PERMISSION OF THE LAND SURVEYOR. THE WORD "CERTIFY" OR "CERTIFICATION" AS SHOWN AND USED HEREON MEANS AN EXPRESSION OF PROFESSIONAL OPINION REGARDING THE FACTS OF THE SURVEY AND DOES NOT CONSTITUTE A WARRANTY OR GUARANTEE, EXPRESSED OR IMPLIED. FENCE LOCATIONS SHOWN ON THIS SURVEY ARE FOR GRAPHICAL INFORMATION ONLY. NO DETERMINATION REGARDING POSSESSORY RIGHTS IS MADE BY THE LAND SURVEYOR. THIS SURVEY IS MADE IN ACCORDANCE WITH THE STANDARDS OF PRACTICE AS ESTABLISHED BY LA. REV. STATUTES TITLE 46: CHAPTER 29, AS A CLASS C SURVEY.


REFERENCE MAP: 1) A RIGHT OF WAY MAP OF STATE PROJECT NOS. 742-17-0145 & 254-02-0045, F.A.P. NOS.170415241 & (7051504) C.P.P. NO.97-CS-HC-0015 CENTRAL THRUWAY, FRENCH TOWN RD. TO SULLIVAN RD. & GREENWELL SPRINGS RD. EAST BATON ROUGE PARISH PHASE 2 ON MAY 10, 2005 BY LYLES BUDDEN
2) A RIGHT OF WAY MAP OF STATE PROJECT NO. 254-02-34 F.A.P. NO. HES-0395(011) GREENWELL SPRINGS RD.- SULLIVAN RD. INTERSECTION EAST BATON ROUGE PARISH OCTOBER 28, 1987 BY ROY J BOURDEAUX.
3) FINAL PLAT SHOWING THE REMOVAL OF LOT B FROM THE ERNEST BUHLER PROPERTY IN EAST BATON ROUGE PARISH, LA ON AUGUST 11, 1955 BY RICHARD A. McEWEN

* BASE BEARING: WESTERN R/W LINE OF CENTRAL THRUWAY (S38°55'15"E) PER REFERENCE MAP 1.

GRAPHIC SCALE

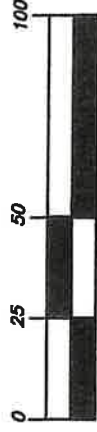

(IN FEET)
1 inch = 50 ft.

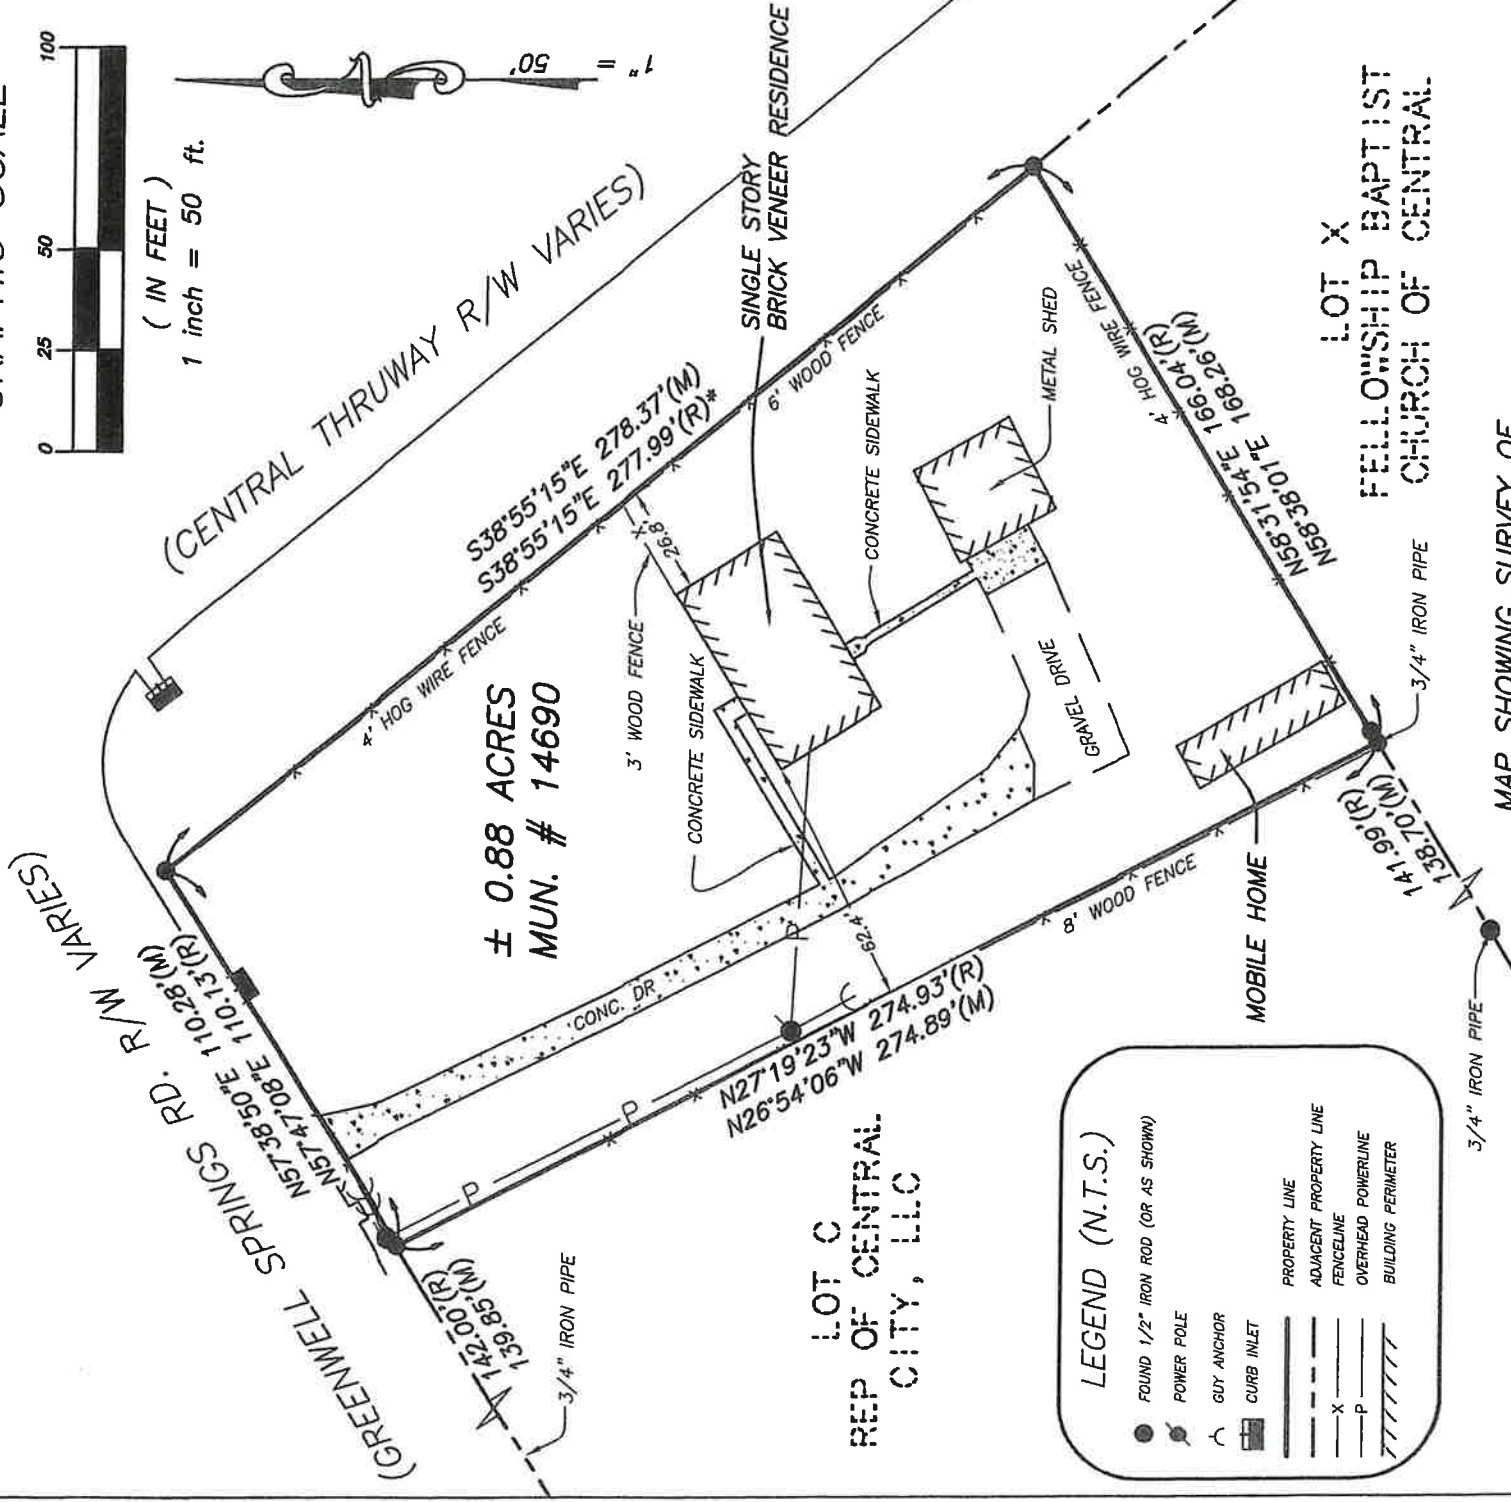

LEGEND (N.T.S.)

●	FOUND 1/2" IRON ROD (OR AS SHOWN)
⚡	POWER POLE
⌋	GUY ANCHOR
⌋	CURB INLET
---	PROPERTY LINE
- - -	ADJACENT PROPERTY LINE
- x -	FENCELINE
- P -	OVERHEAD POWERLINE
	BUILDING PERIMETER

MAP SHOWING SURVEY OF
14690 GREENWELL SPRINGS RD.

LOCATED IN
SECTION 38, T-6-S, R-2-E
GREENSBURG LAND DISTRICT,
EAST BATON PARISH, LA

FOR
DEBORAH DAVIS SMITH, ET AL.



I CERTIFY THAT I MADE THE SURVEY SHOWN HEREON, THAT IT IS IN ACCORDANCE WITH THE FIELD NOTES OF SAID SURVEY, AND THAT THERE ARE NO SIGNIFICANT VISIBLE ENCROACHMENTS EITHER WAY ACROSS PROPERTY LINES, UNLESS OTHERWISE NOTED.

Gerald W. Middleton, Jr.
GERALD W. MIDDLETON JR., P.L.S. DATE 6/13/18



A Division of Forte & Tablada
9107 INTERLINE AVE. BATON ROUGE, LA 70809 PH: (225) 752-0336

PROJECT NO.	181224
FIELDBOOK NO.	537/42RS
FIELDBOOK DATE	6/11/2018
DRAWN BY	S.ROBERTSON
CHECKED BY	G.MIDDLETON