AREA CALCULATIONS	
SPACE	AREA (SQUARE FEET)
SITE	
GREEN	13,358 SQUARE FEET
CONCRETE	23,939 SQUARE FEET
SIDEWALK	3,890 SQUARE FEET
BUILDING	
BUILDING I 1ST FLOOR	8,778 SQUARE FEET
BUILDING I 2ND FLOOR	9,102 SQUARE FEET
BUILDING I 3RD FLOOR	9,102 SQUARE FEET
BUILDING I COVERED DOCK	1,138 SQUARE FEET
BUILDING II	11,799 SQUARE FEET
BUILDING II CANOPY	1,168 SQUARE FEET
BUILDING III	5,971 SQUARE FEET
BUILDING III CANOPY	1,287 SQUARE FEET
BUILDING IV	552 SQUARE FEET
TOTAL SITE AREA	69,425 SQUARE FEET

AREA CALCULATIONS	
ROW TAKEN	AREA (SQUARE FEET)
SITE	
GREEN	345 SQUARE FEET
CONCRETE	212 SQUARE FEET
TOTAL SITE AREA	557 SQUARE FEET

AREA CALCULATIONS	
CS TAKEN	AREA (SQUARE FEET)
SITE	
GREEN	840 SQUARE FEET
CONCRETE	920 SQUARE FEET
TOTAL SITE AREA	1,760 SQUARE FEET

PARKING COUNT

STANDARD PARKING SPACES	67
ACCESSIBLE SPACES	2
TOTAL PARKING SPACES	69



1 **AS-BUILT SITE PLAN**
1" = 30'-0"

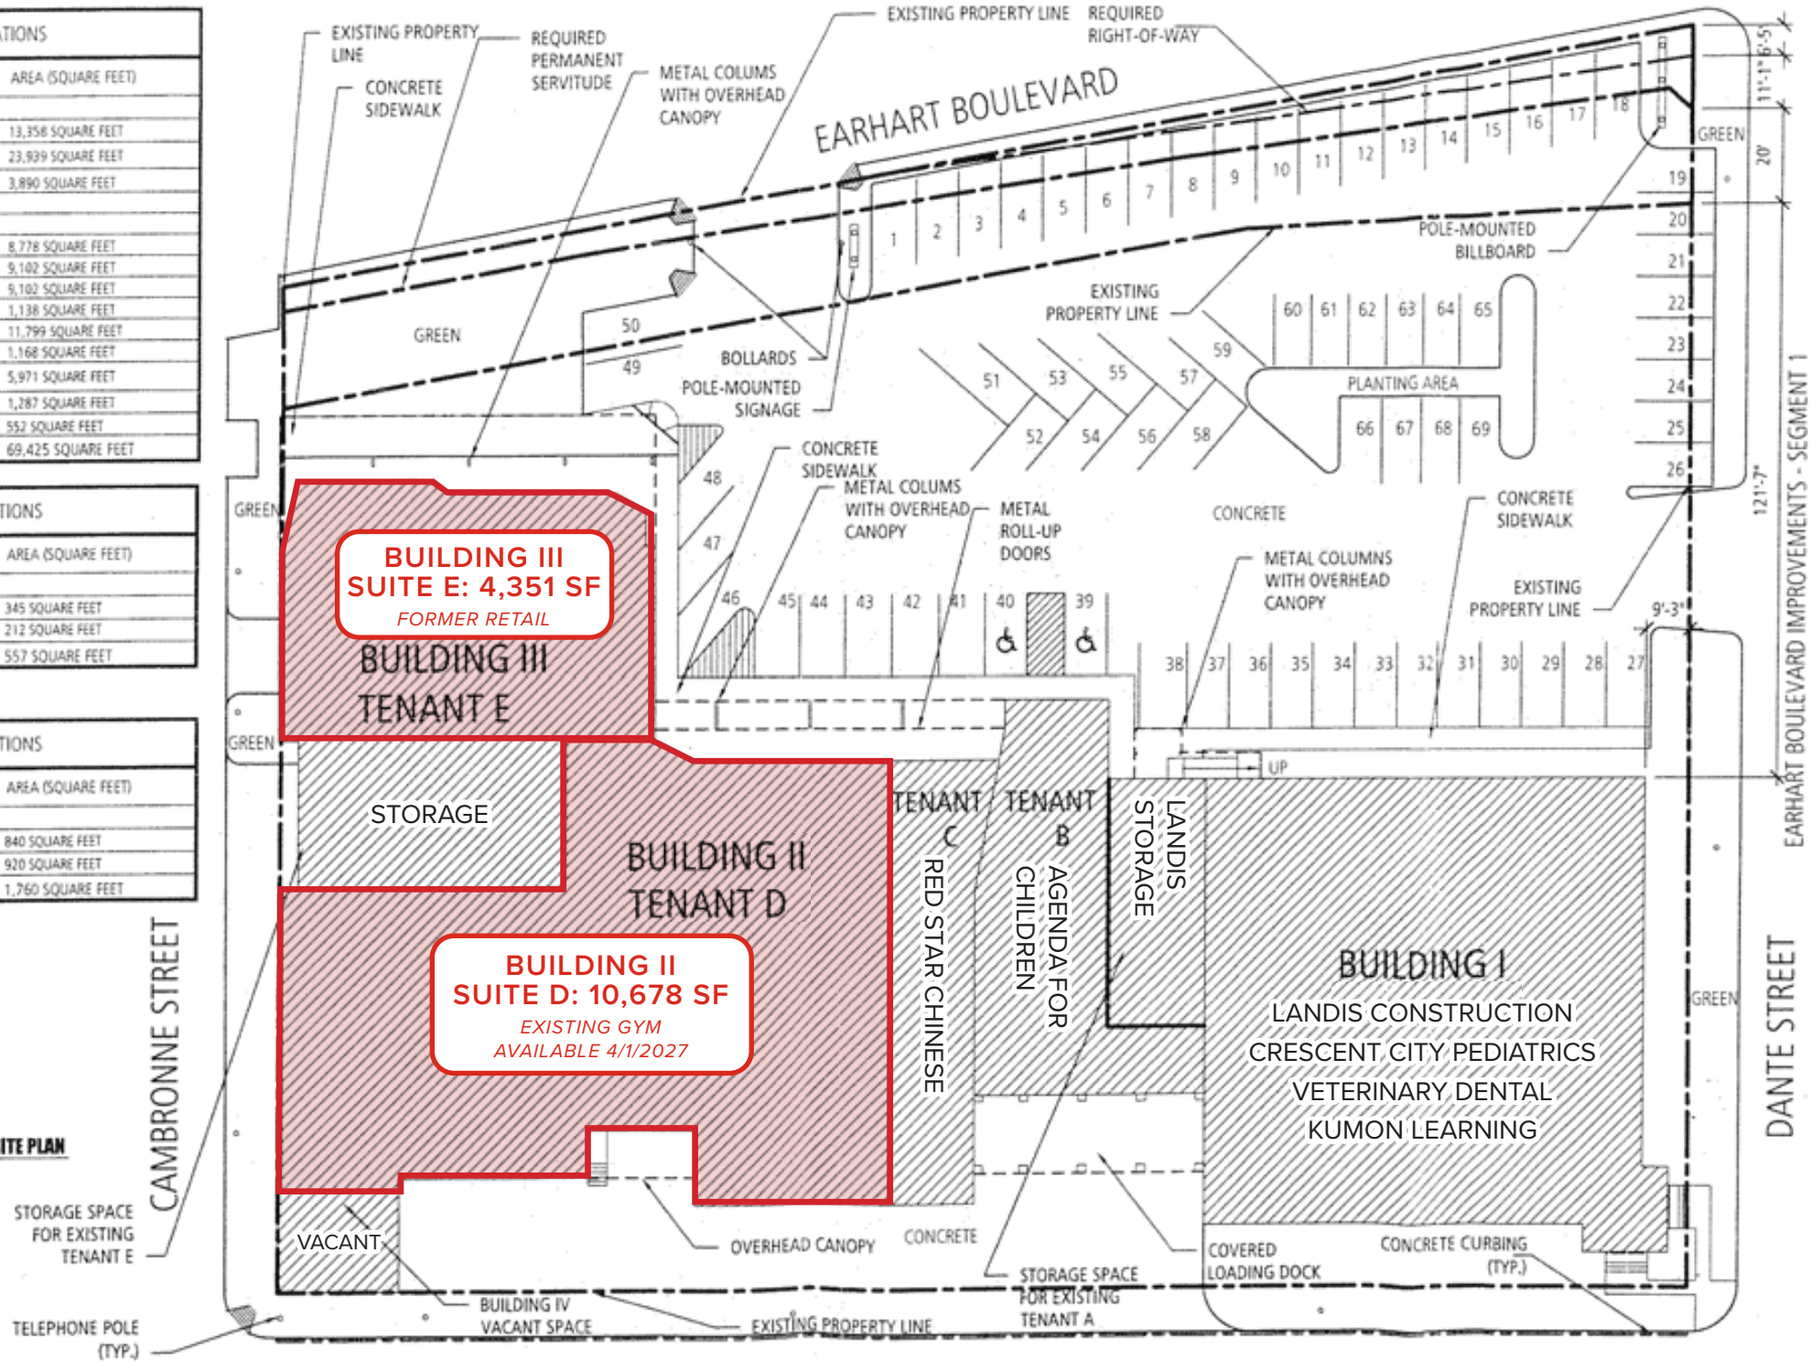

EARHART BOULEVARD IMPROVEMENTS - SEGMENT 1

STATE PROJECT NUMBER 742-36-0008

DPW PROJECT NUMBER 91-ST-04
FAP NO. STP-6033(009)M
URS PROJECT NUMBER 04-00046168.01/10000002.00000

ARCHITECTS +
A LIMITED LIABILITY COMPANY

A1.1

PARCEL 453-S12A