


DEALERS AVE. (SIDE)

PARCEL 6
ELMWOOD INDUSTRIAL PARK
JEFFERSON PARISH, LA.

(SIDE)

ST.

MOUNES

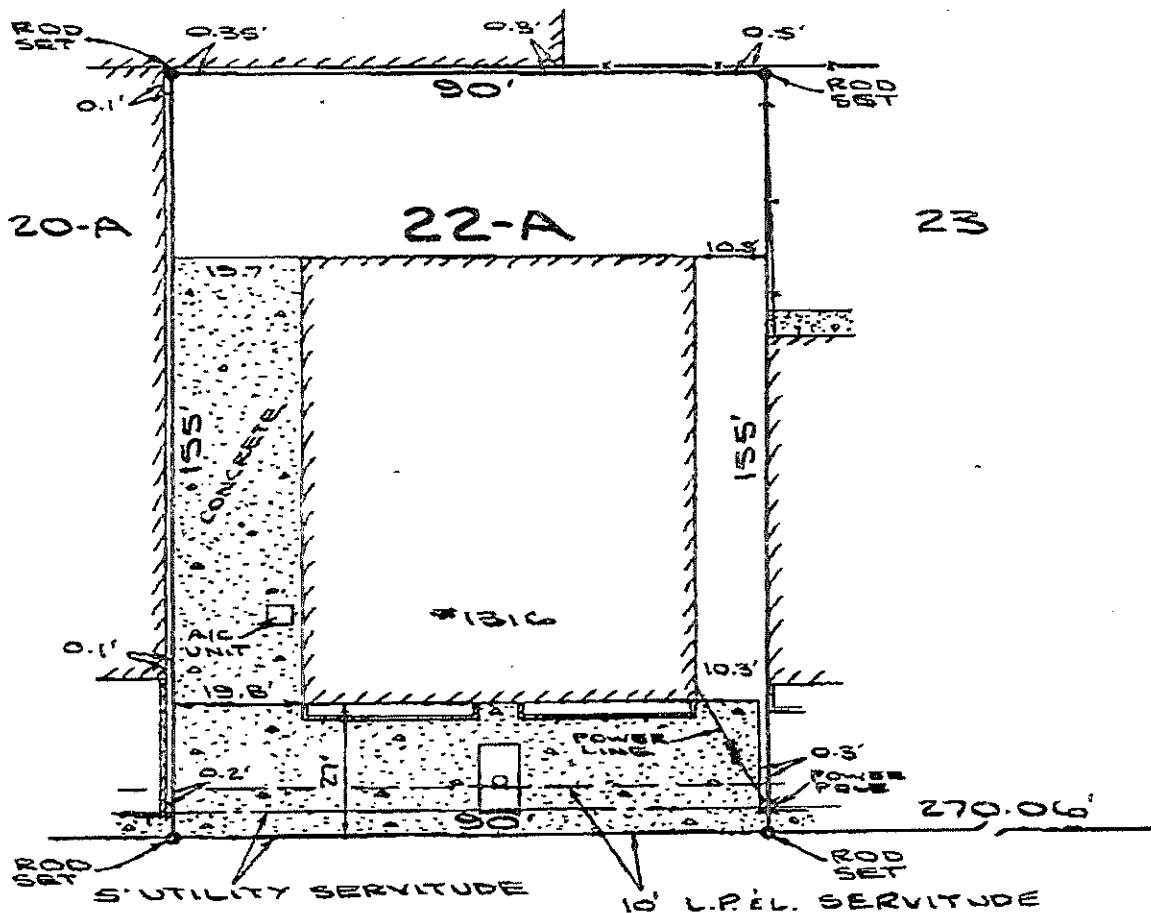

ST.

POWELL

DISTRIBUTORS

ROW



METAIRIE, LA.
NOV. 20, 1990
SURVEY MADE AT THE REQUEST OF RATHBOR
LAND CO., INC.; WINDHORST, GAUDRY TALLEY;
RANSON, R.F.J. LAND, INC.; FIRST AMERICAN
TITLE INSURANCE CO.

CERTIFIED CORRECT
J. J. KREBS & SONS, INC.

BY *Randall W. Brown*

JOS No. 900700