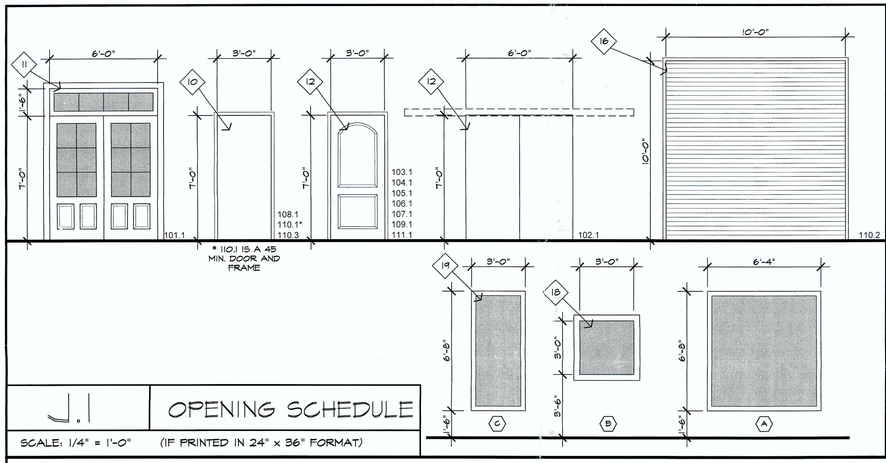

J.1 OPENING SCHEDULE

SCALE: 1/4" = 1'-0" (IF PRINTED IN 24" x 36" FORMAT)

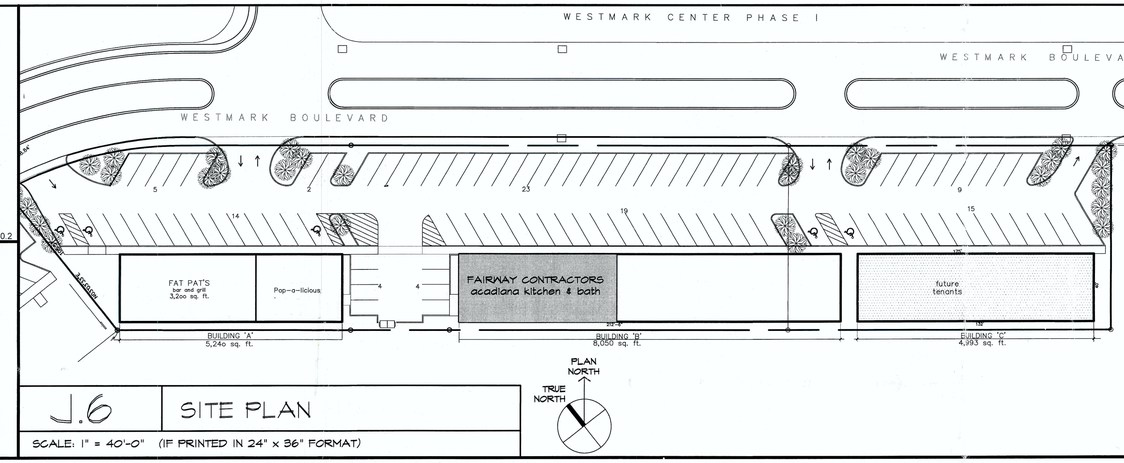

J.6 SITE PLAN

SCALE: 1" = 40'-0" (IF PRINTED IN 24" x 36" FORMAT)

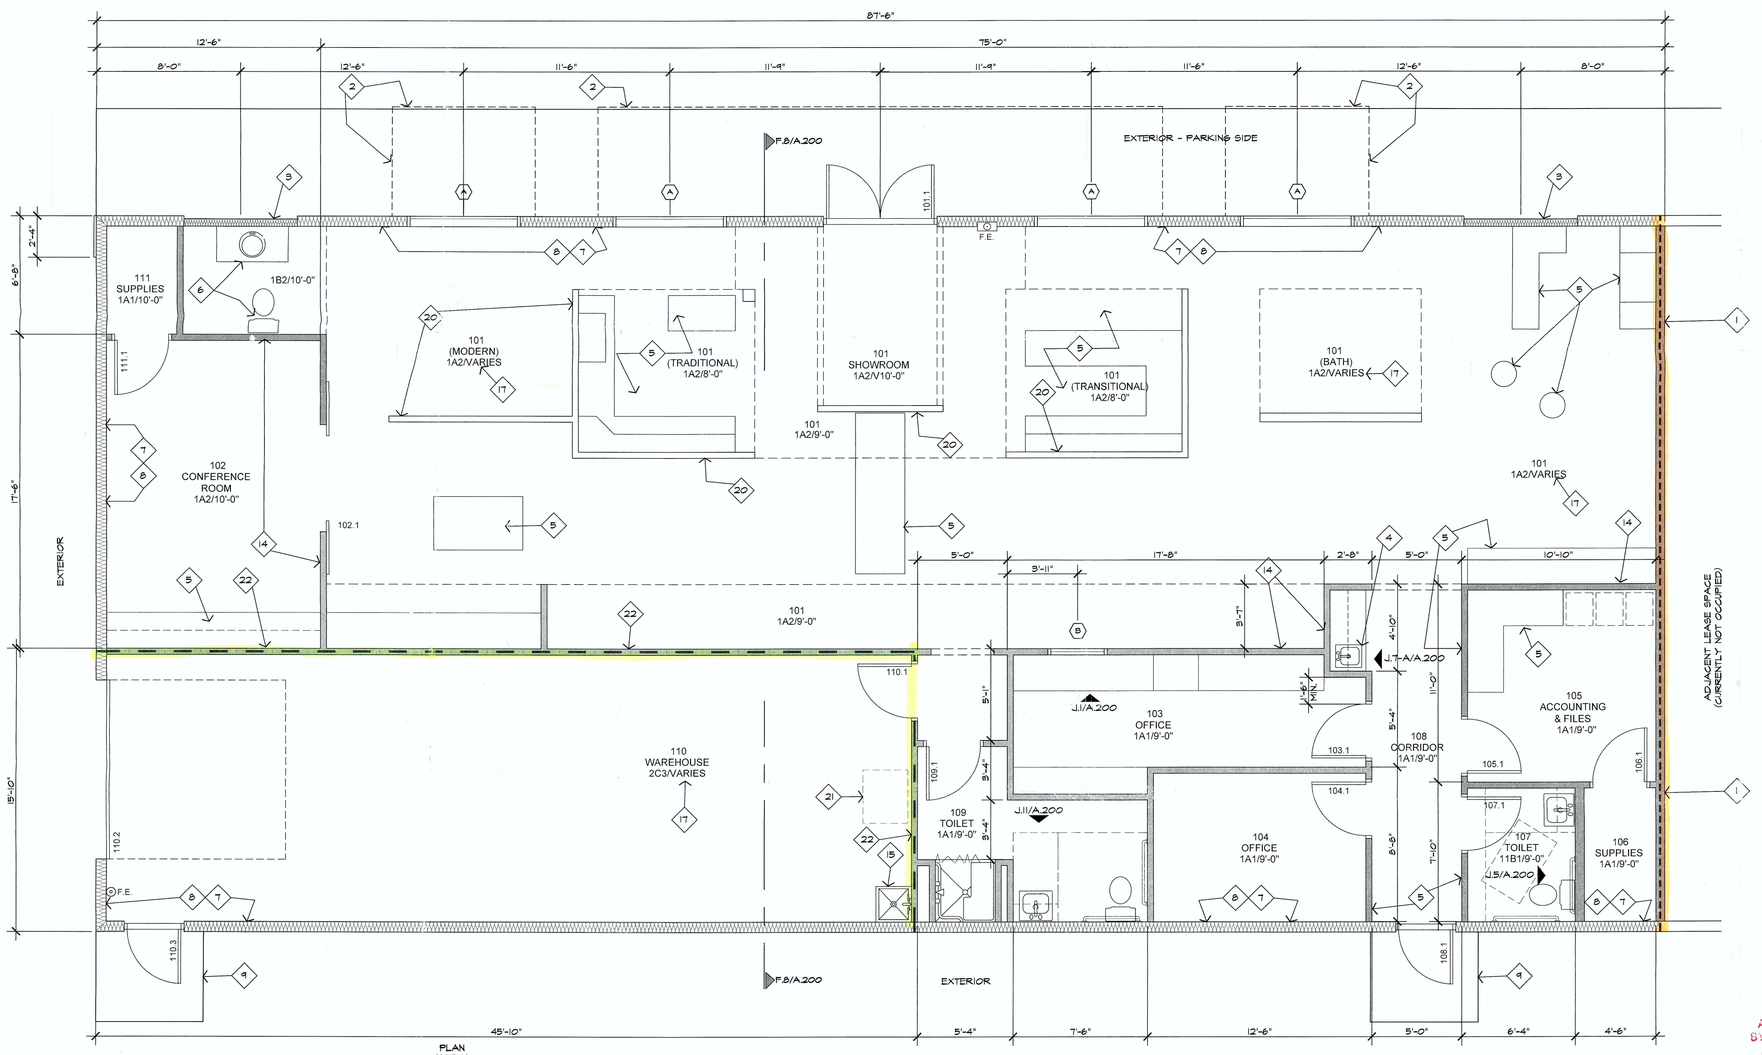

A.1 FLOOR PLAN

SCALE: 1/4" = 1'-0" (IF PRINTED IN 24" x 36" FORMAT)

0476235

REVIEWED FOR
STATE FIRE MARSHAL
AS PER REVIEW LETTER
BY: F. MICHAEL BABINEAUX

101 ← ROOM NUMBER
LOBBY ← ROOM NAME
FLOOR/ BASE → 3F6/10'-0" ← CEILING HEIGHT **
CEILING FINISH
WALL FINISH
** V= VARIES

FINISH SCHEDULE

	FLOOR/BASE		WALL		CEILING
1	STAINED CONCRETE/ 4" VINYL	A	PAINTED GYPSUM BOARD	1	2" x 2" SUSPENDED ACOUSTICAL
2	CONCRETE	B	4' CERAMIC TILE WAINSCOT W/ WALL PAPER ON GYPSUM BOARD ABOVE	2	OPEN TO DECK PAINTED BLACK
3		C	TAPED AND FLOATED UNPAINTED GYPSUM BOARD	3	OPEN TO DECK (UNPAINTED)

KEYNOTES:

1. THIS WALL IS A TWO HOUR RATED (UL ASSEMBLY U301) AND IS SHARED W/ ADJACENT TENANT. WHERE NOTED, DIMENSIONS ARE TO CENTERLINE OF WALL. EXTEND TO UNDERSIDE OF ROOF DECK.
2. CANOPY ABOVE, SEE NORTH ELEVATION.
3. RECESSED, VERY SMOOTH STUCCO PANELS, WITH ACCENT COLOR FINISH.
4. 12" BAR SINK IN PLASTIC LAMINATE COUNTER TOP. CABINETS AT BOTTOM TO BE BRISTOL RED, AND AT TOP TO BE AUTUMN BROWN.
5. DISPLAY/MILLWORK TO BE FURNISHED BY TENANT, INSTALLED BY CONTRACTOR.
6. SPA BATH VIGNETTE (NON-WORKING PLUMBING), FURNISHED BY TENANT, INSTALLED BY CONTRACTOR.
7. PROVIDE AND INSTALL R-19 INSULATION IN ALL EXTERIOR WALLS.
8. PROVIDE AND INSTALL 5/8" GYPSUM BOARD ON INSIDE OF ALL EXTERIOR WALLS, UNLESS NOTED OTHERWISE.
9. 6'-0" x 6'-0" CONCRETE PAD, LEVEL WITH FINISH FLOOR AT DOOR, WITH MAX. 2% SLOPE.
10. HOLLOW METAL DOOR IN HOLLOW METAL FRAME.
11. DECORATIVE, INSULATED METAL & GLASS DOOR AND TRANSOM IN METAL FRAME.
12. MASONITE RAISED PANEL DOOR IN WOOD FRAME.
13. BARN DOORS, ON EXPOSED SLIDING RAIL.
14. WALL EXTENDS TO DECK.
15. MOP SINK.
16. METAL COILING DOOR, PAINTED, WITH METAL FRAME.
17. PROVIDE 5 1/2" CROWN MOLDING @ 10', WALL PAINTED BLACK ABOVE MOLDING.
18. FIXED ONE WAY GLASS IN WOOD FRAME.
19. WINDOW UNIT WITH INSULATED FROSTED GLASS.
20. WALL IS 10'-0" TALL; BRACE AS NEEDED.
21. REFRIGERATOR, BY TENANT. PROVIDE WATER LINE.
22. THIS WALL IS ONE HOUR RATED. (UL ASSEMBLY U305)

GENERAL NOTES

- ALL PLASTIC LAMINATE TO BE WILSON ART.

LEGEND

- EXISTING WALL TO REMAIN.
- NEW WALL.
- NEW ONE HOUR RATED WALL. UL ASSEMBLY U305
- F.E. SEMI-RECESSED CABINET FIRE EXTINGUISHER
- F.E. WALL HUNG FIRE EXTINGUISHER
- NEW ONE HOUR RATED WALL. UL ASSEMBLY U301

PER NOTE 1 ABOVE

NO.	REVISIONS/SUBMISSIONS	DATE

Lynn Guidry
ARCHITECT
411 ARCENEAUX ROAD CARENCRO LOUISIANA 70520
p 337.896.6645 f 337.896.1444 email. lynn@lynnguidryarchitect.com

ACADIANA KITCHEN & BATH AND FAIRWAY CONTRACTORS

A TENANT IN WESTMARK CENTER, BUILDING 2B

2015

WESTMARK BOULEVARD LAFAYETTE, LOUISIANA

Drawing Title: TENANT IMPROVEMENTS: FLOOR PLAN, SITE PLAN

Designed: LCG	Project No.: 2009.007.02.02
Drawn: BP	Scale: AS NOTED
Checked: LCG	Drawing No.: A.100R
Reviewed	
Date: SEPT. 30, 2015	1 OF 2