



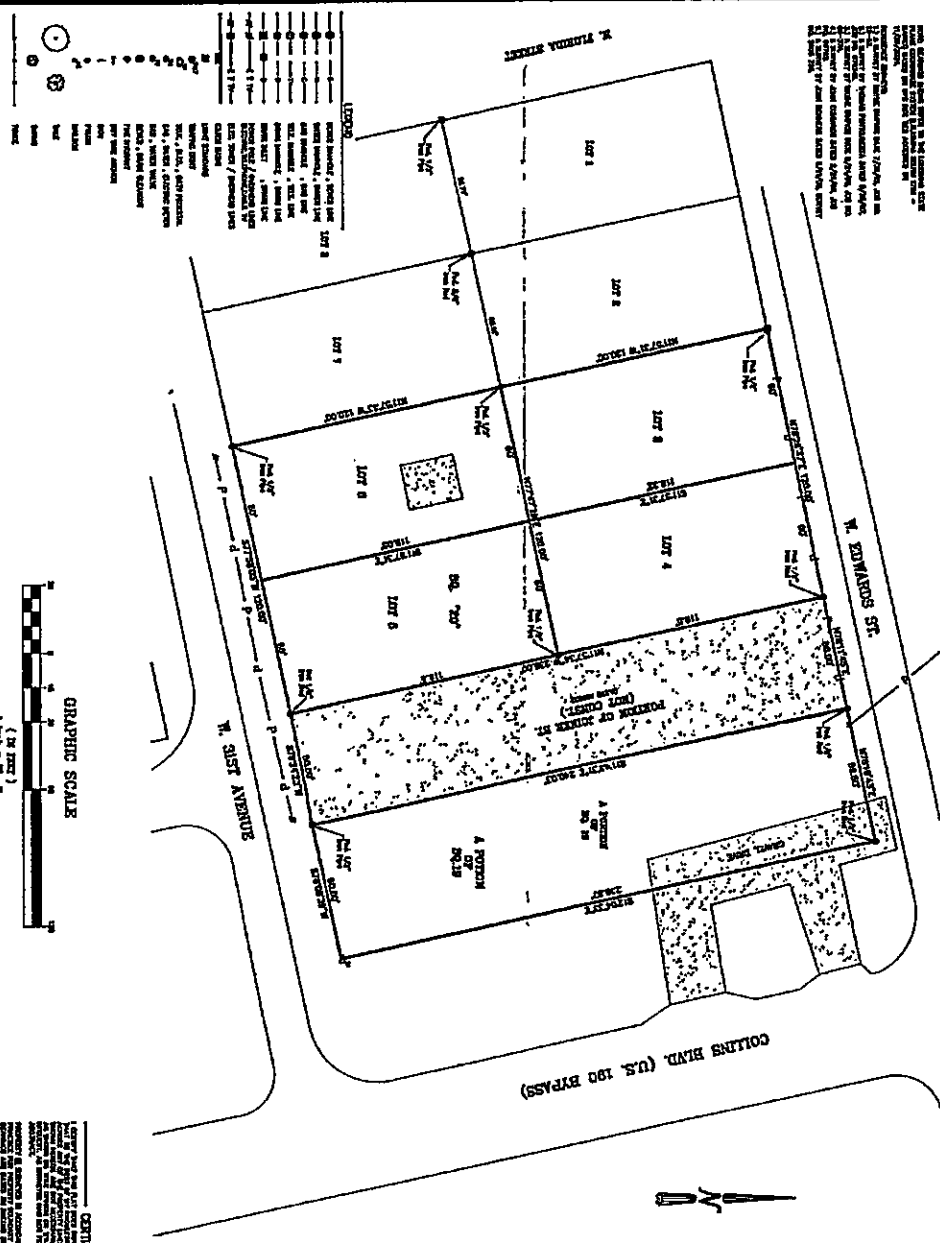

CERTIFICATION


 J. V. Burkes
 Surveyor

DATE: 12/03/2014

A SURVEY PLAT OF LOTS 3 THRU 5, SQ. 20 & A PORTION OF SQ. 19, CONLEY ADD. TO COVINGTON, THE REVOKED PORTION OF JONER STREET CITY OF COVINGTON, ST. TAMMANY PARISH, LOUISIANA

 DATE: 12/03/2014

J.V. Burkes & Associates, Inc.
 SURVEYING ENGINEERING & ENVIRONMENTAL

1025 Shortcut Highway
 Slacks, Louisiana 70452
 E-mail: jburkes@jvburkes.com

Phone 504-885-0005 Fax 504-885-0004

