


WILKINSON STREET

NOTE: Setback lines shall be verified by owner or contractor prior to any construction, as an abstract has not been performed by the undersigned.

REFERENCE SURVEY BY RANDALL M. BROWN,
DATED FEBRUARY 6, 1995, SURVEY NO.
95079, FOR WARREN E. MUNSTER AND
WAYNE MUNSTER.

NOTE: BEARINGS SHOWN ARE TAKEN FROM THE
RECORDED PLAN OF SUBDIVISION OF GOLDEN
SHORES, SECTION L, BY ADLOE ORR, JR.,
DATED SEPTEMBER 16, 1954. WHICH NOTE
BEARINGS ARE ASSUMED.

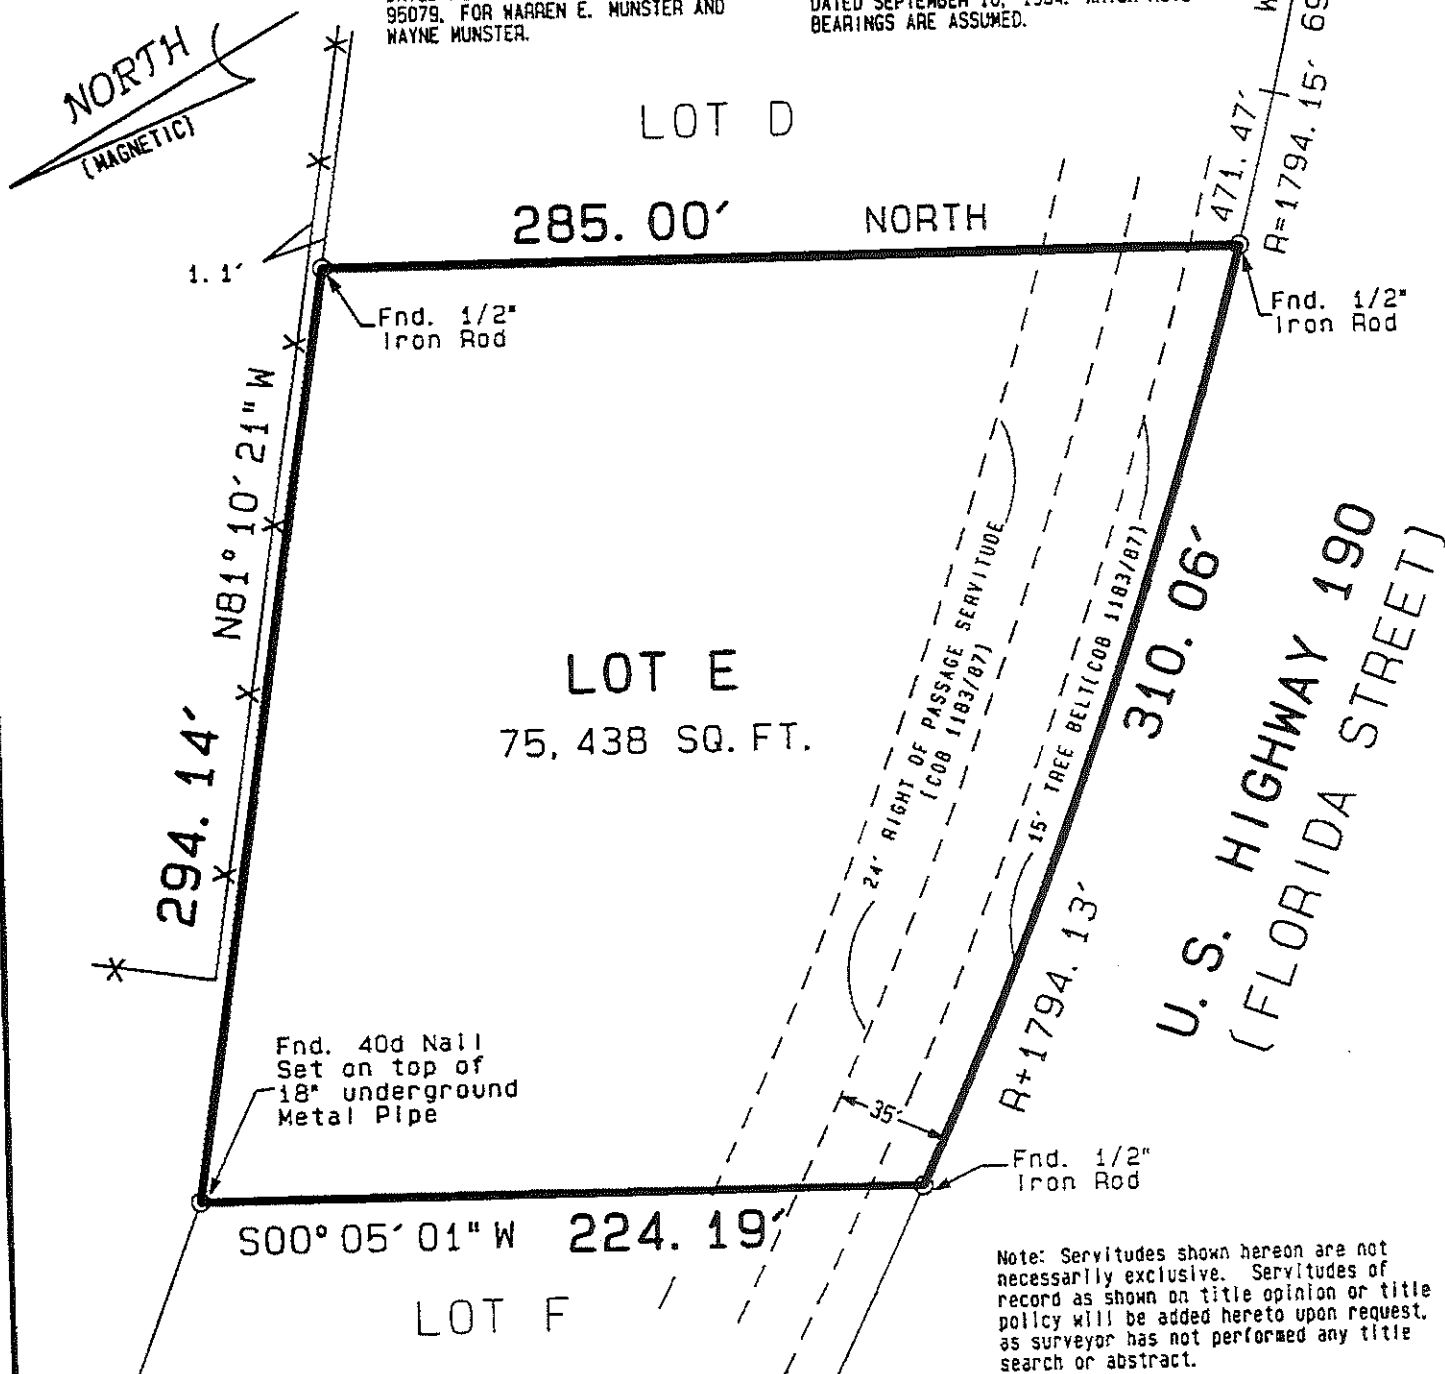

Note: Servitudes shown hereon are not necessarily exclusive. Servitudes of record as shown on title opinion or title policy will be added hereto upon request, as surveyor has not performed any title search or abstract.

Note: This is to certify that I have consulted the Federal Insurance Administration Flood Hazard Boundary Maps and found the property described is located in Flood Zone(s) "B" with a Base Flood Elevation of N/A in accordance with Community Panel No. 220202 0002 C ; Revised: APRIL 4, 1983

This is to certify that I have done an actual ground survey and found that no encroachments exist either way across any property lines except as shown.

THIS IS TO CERTIFY THAT THIS SURVEY WAS DONE UNDER MY DIRECT SUPERVISION AND CONTROL; AND THAT THE SURVEY WAS DONE ON THE GROUND AND IS IN ACCORDANCE WITH THE "MINIMUM STANDARDS FOR PROPERTY BOUNDARY SURVEYS" AS ADOPTED BY THE STATE OF LOUISIANA, BOARD OF REGISTRATION FOR PROFESSIONAL ENGINEERS AND LAND SURVEYORS FOR A CLASS "8" SURVEY.

SURVEY MAP OF
LOT E, GOLDEN SHORES, SECTION L
in
CITY OF MANDEVILLE