


MODEL CODES
2012 IRC

3/20/17

REVIEWED FOR CODE COMPLIANCE

EAST FELICIANA PARISH
BUILDING INSPECTION DEPT.

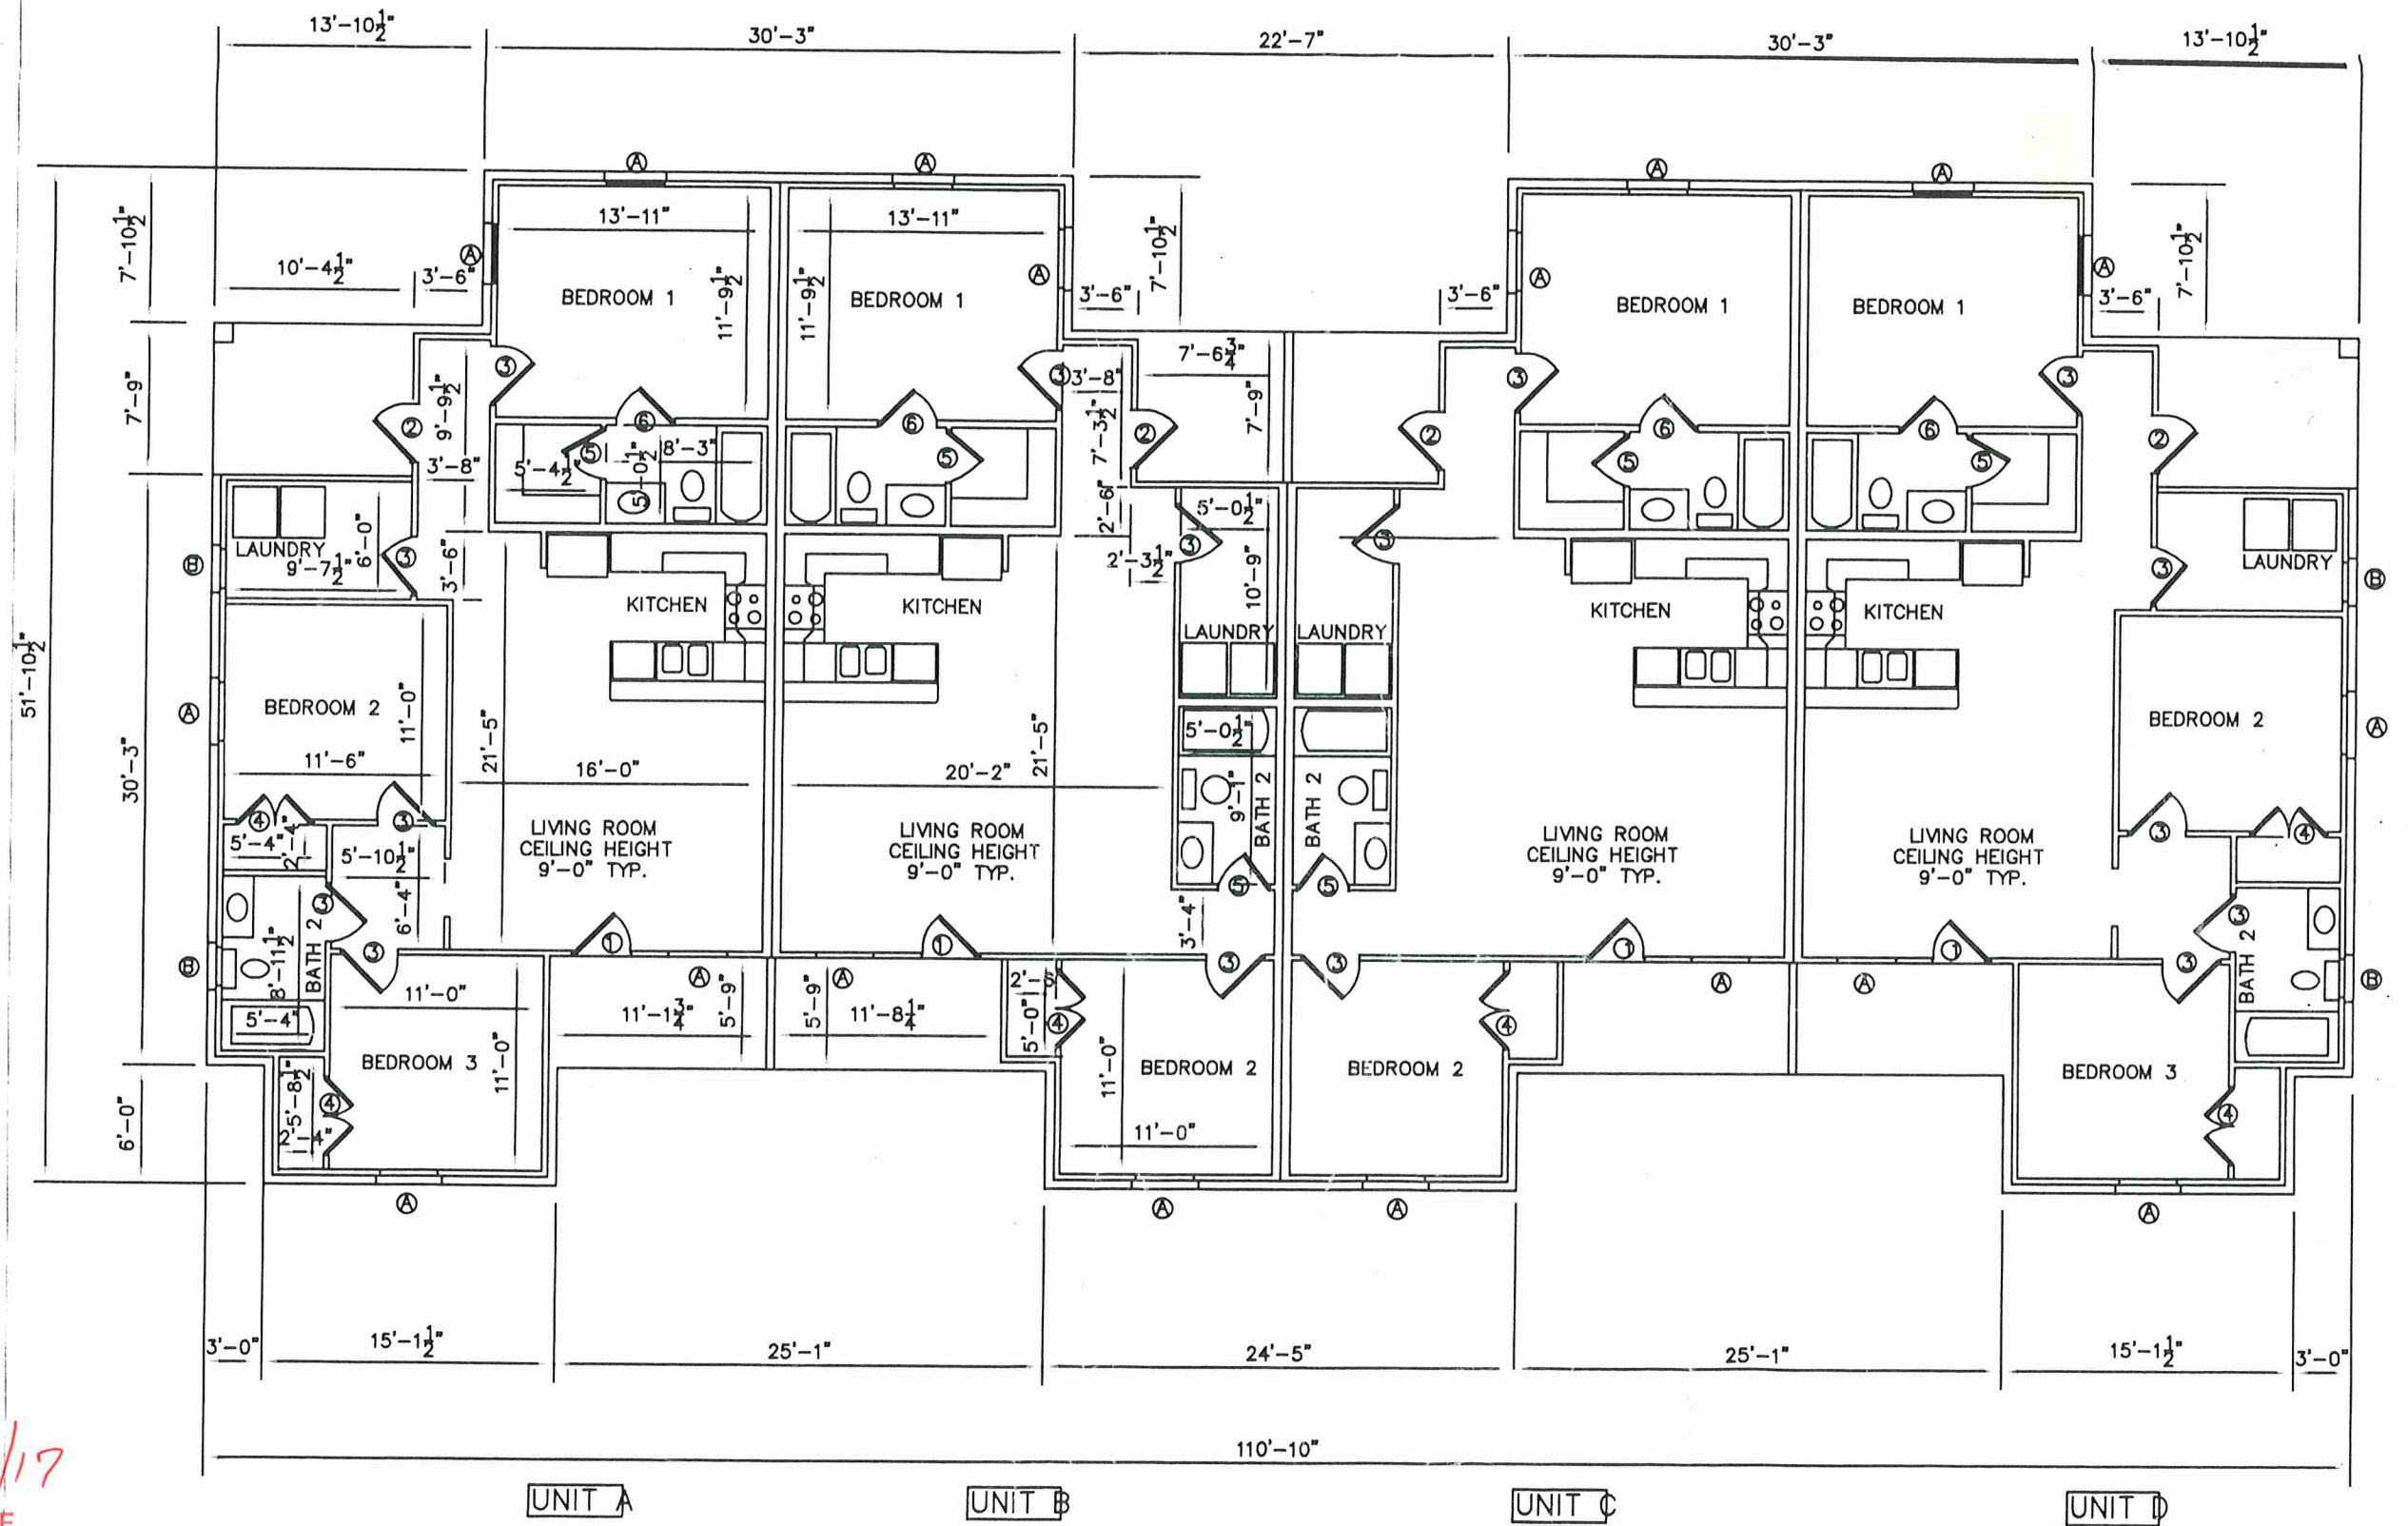

FLOOR PLAN

Y965 112 888