


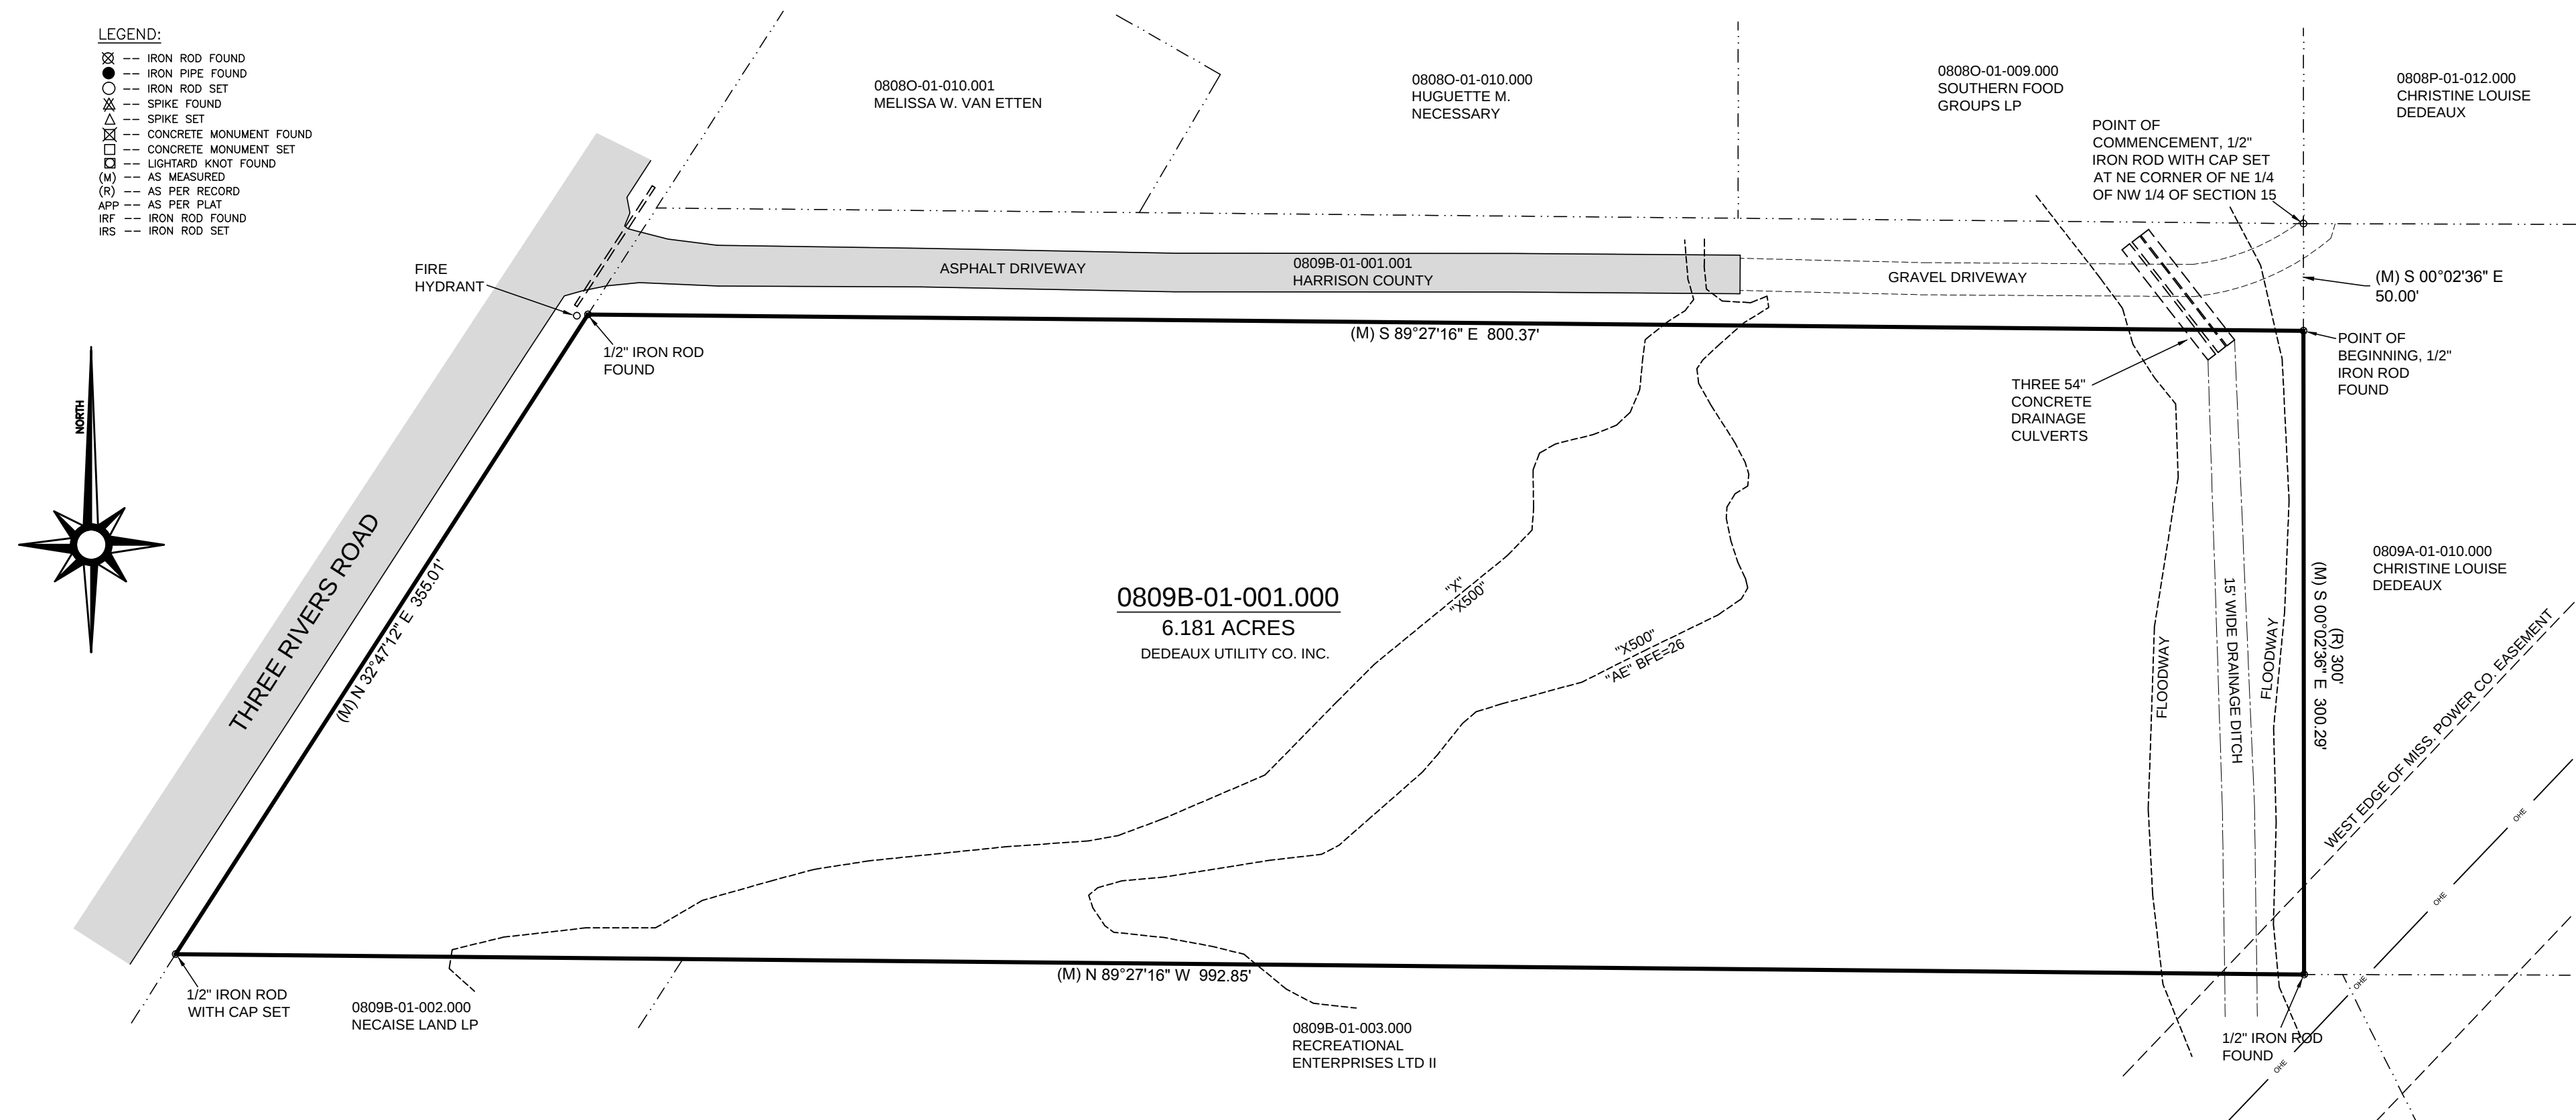

LEGEND:

NOTES:

SURVEY DESCRIPTION:

REFERENCE MATERIALS:



THIS PROPERTY IS LOCATED IN F.I.R.M. ZONE <u>AS SHOWN HEREON</u> ACCORDING TO MAP NUMBER <u>28047C0254H</u> DATED <u>12/21/2017</u>		
SURVEY CLASS - "B" SCALE: 1" = 60'	FOR: DEDEAUX UTILITY CO., INC.	BEARINGS SHOWN HEREON ARE DERIVED BY: GPS OBSERVATION, STATE PLANE COORDINATES
 CROSBY SURVEYING PROFESSIONAL LAND SURVEYING 716 LIVE OAK DRIVE BILOXI, MISSISSIPPI 39532 PHONE: 228-234-1649 EMAIL: cliffordcrosby@cableone.net		DATES OF FIELD WORK: 12/30/2019 PARTY CHIEF: CC INSTRUMENT MAN: DM RODMAN: CC DRAWN BY: CAC DRAWING NUMBER: 19558 REVISED: