


57.

45.

DRIVE (SIDE)

MODISANT

CLAY

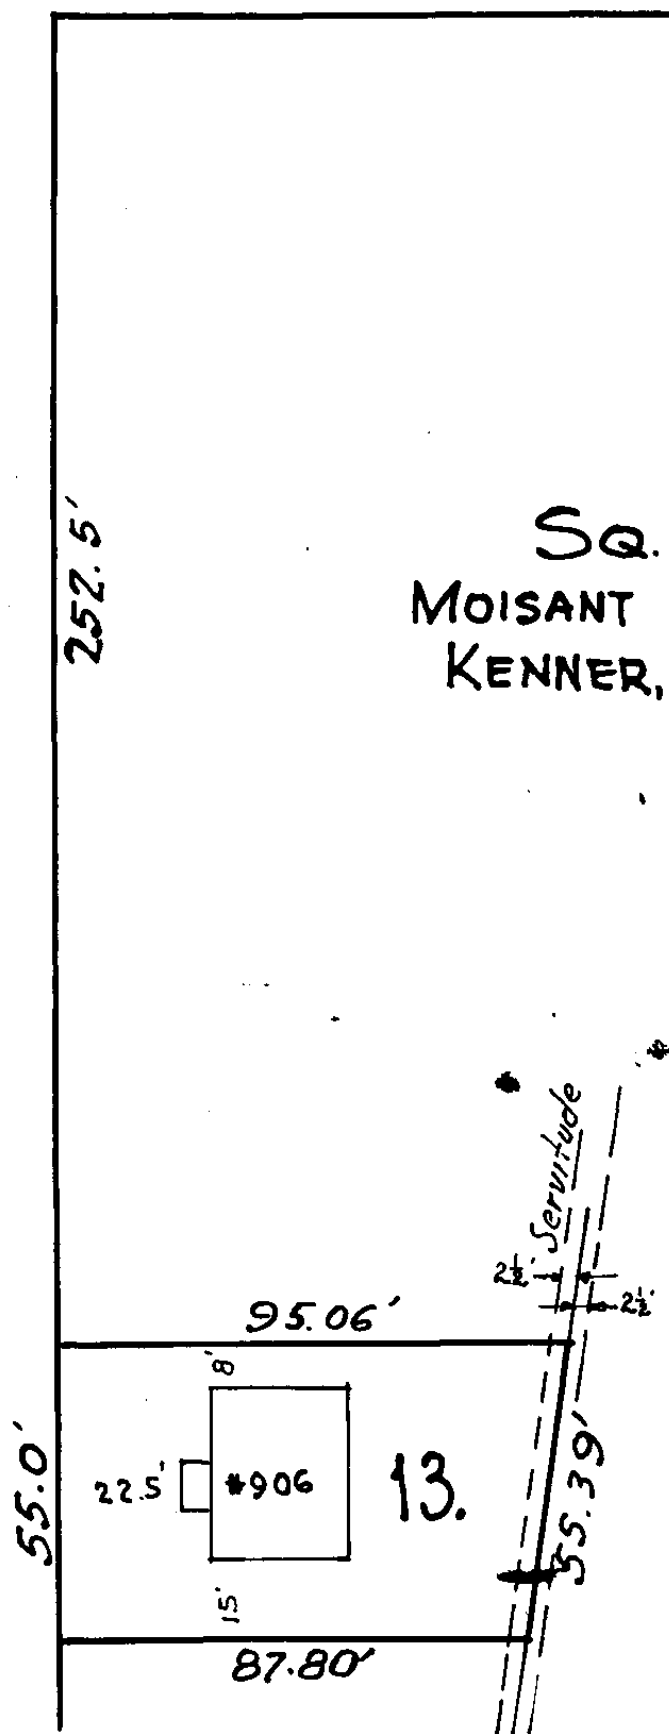

AIRLINE HIGHWAY (SIDE)

New Orleans, La., Nov. 19, 1947.

Survey certified correct. Made at the request
of W.B. Leedy & Co., Inc. (Lloyd), Kansas City Title Ins.Co.

ADLOE ORR,
CIVIL ENGINEER