


3rd floor Floor Plan - Potential Subdivision

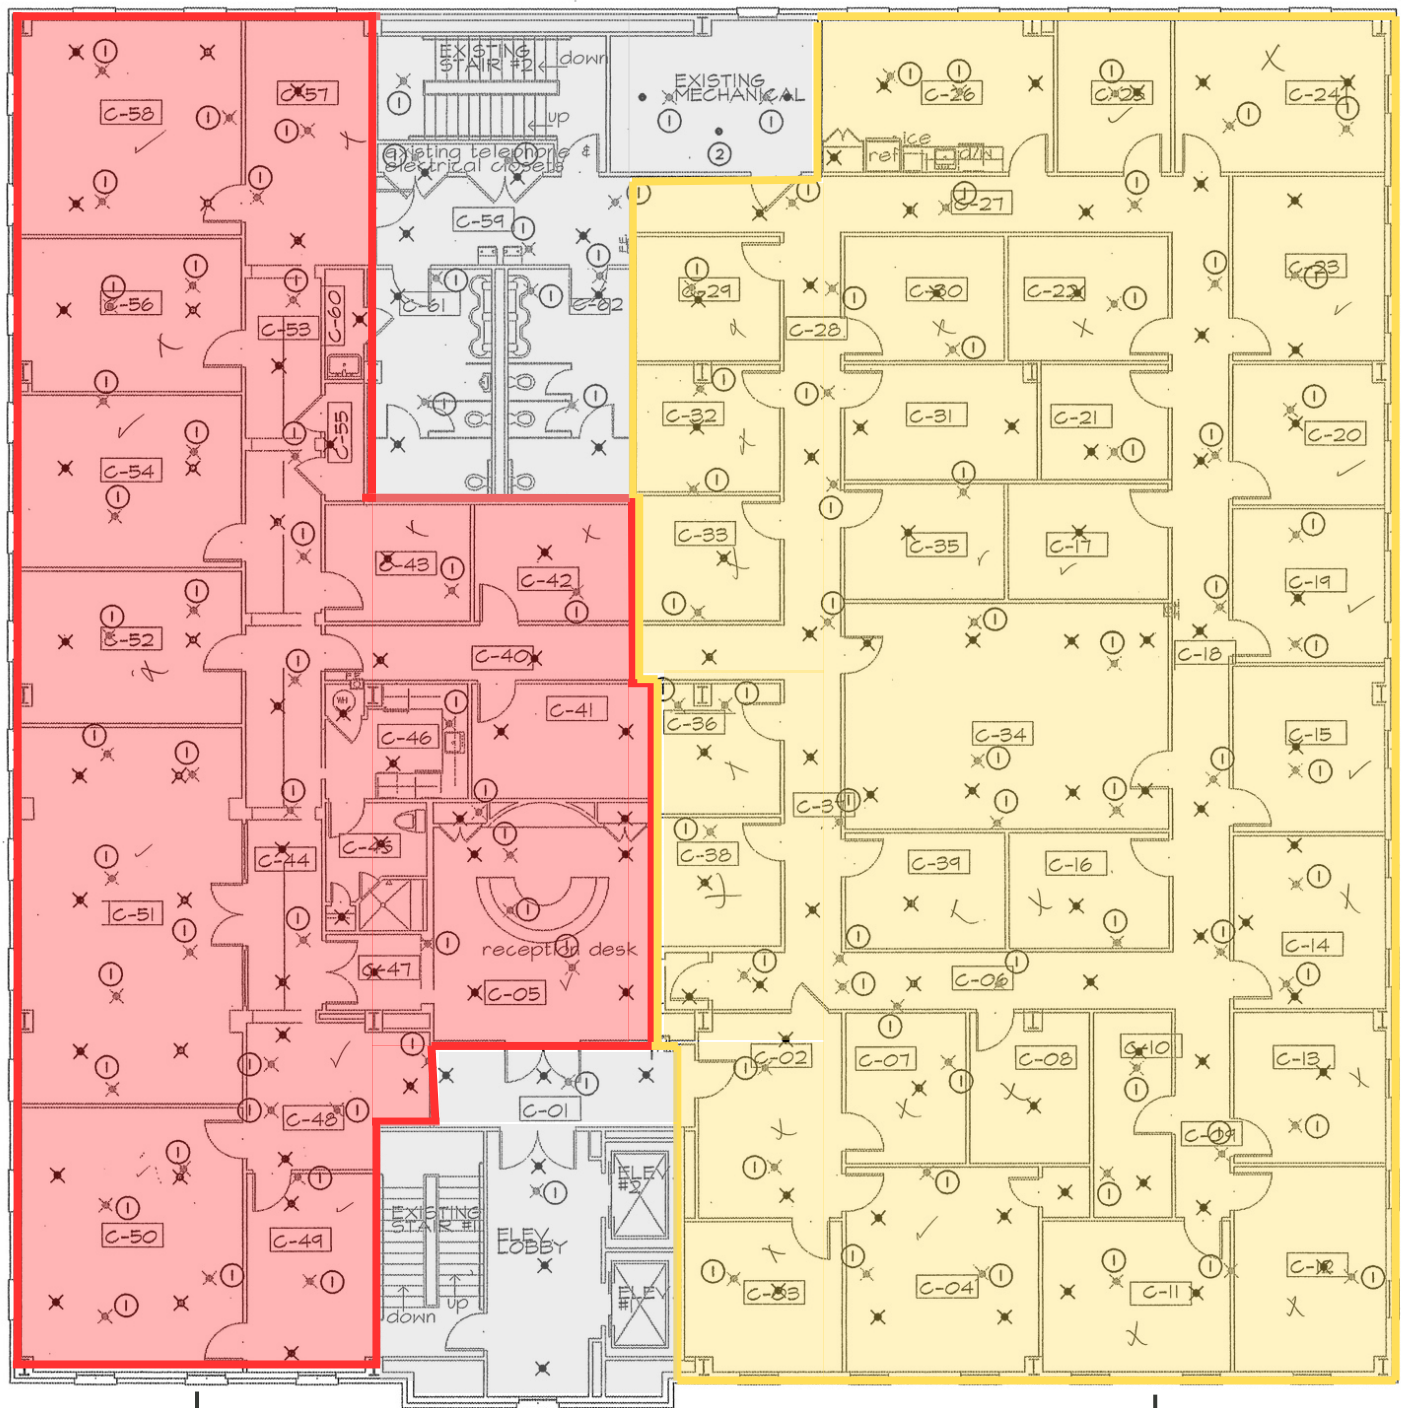

Suite 300
5,656 Sf

Sq Ft Total
12,000 Sf

Suite 301
6,344 Sf



JEFF LANDRY, CCIM
MANAGING BROKER, PARTNER
337-257-5380
JEFF@SCOUTREC.COM

REX MOROUX, CCIM
BROKER, PARTNER
337-257-8133
REX@SCOUTREC.COM

**700 St. John St.
Lafayette, LA 70501**

617 S BUCHANAN ST, LAFAYETTE LA, 70501 | 337-443-0880 | SCOUTREC.COM