


C-4

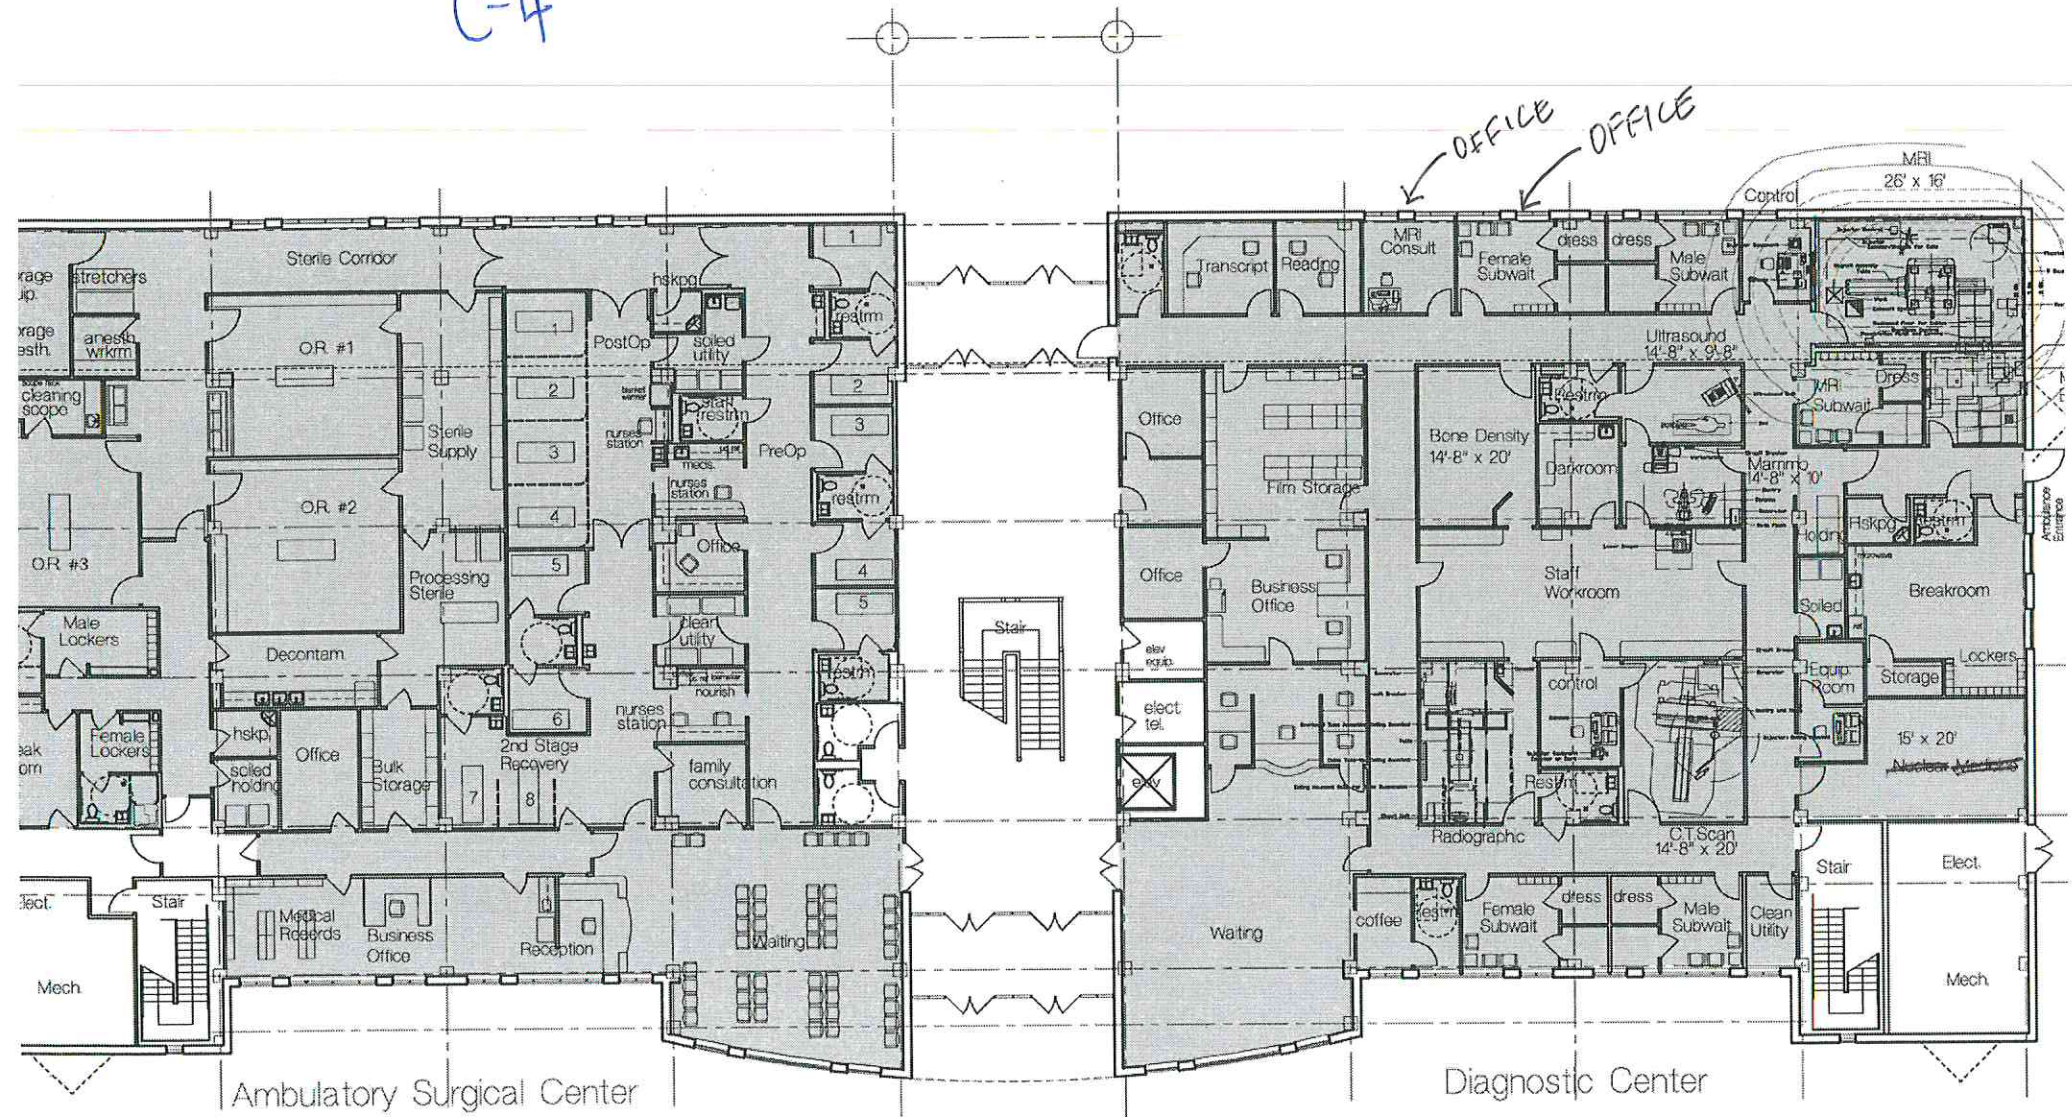

Riverpark Medical Center
First Floor



AREA = 24,176 SF