2-Hour Fire Barrier, UL Design No. U-301
extend to underside of floor and roof deck.
Seal all penetrations per Arch Notes.
Install Fire Dampers in all Duct penetrations.

1-Hour Fire Barrier, UL Design No. U-305
extend to underside of 1-Hour Ceiling system.
Seal all penetrations per Arch Notes.

2-Hour Fire Rate Floor / Ceiling Assembly
per UL DESIGN NO. L538
Seal all penetrations per Arch Notes.

New 3-0 x 6-8 Wood Door and Frame, Storeroom Latch
and Closer - 90 min. Fire Rated Assembly

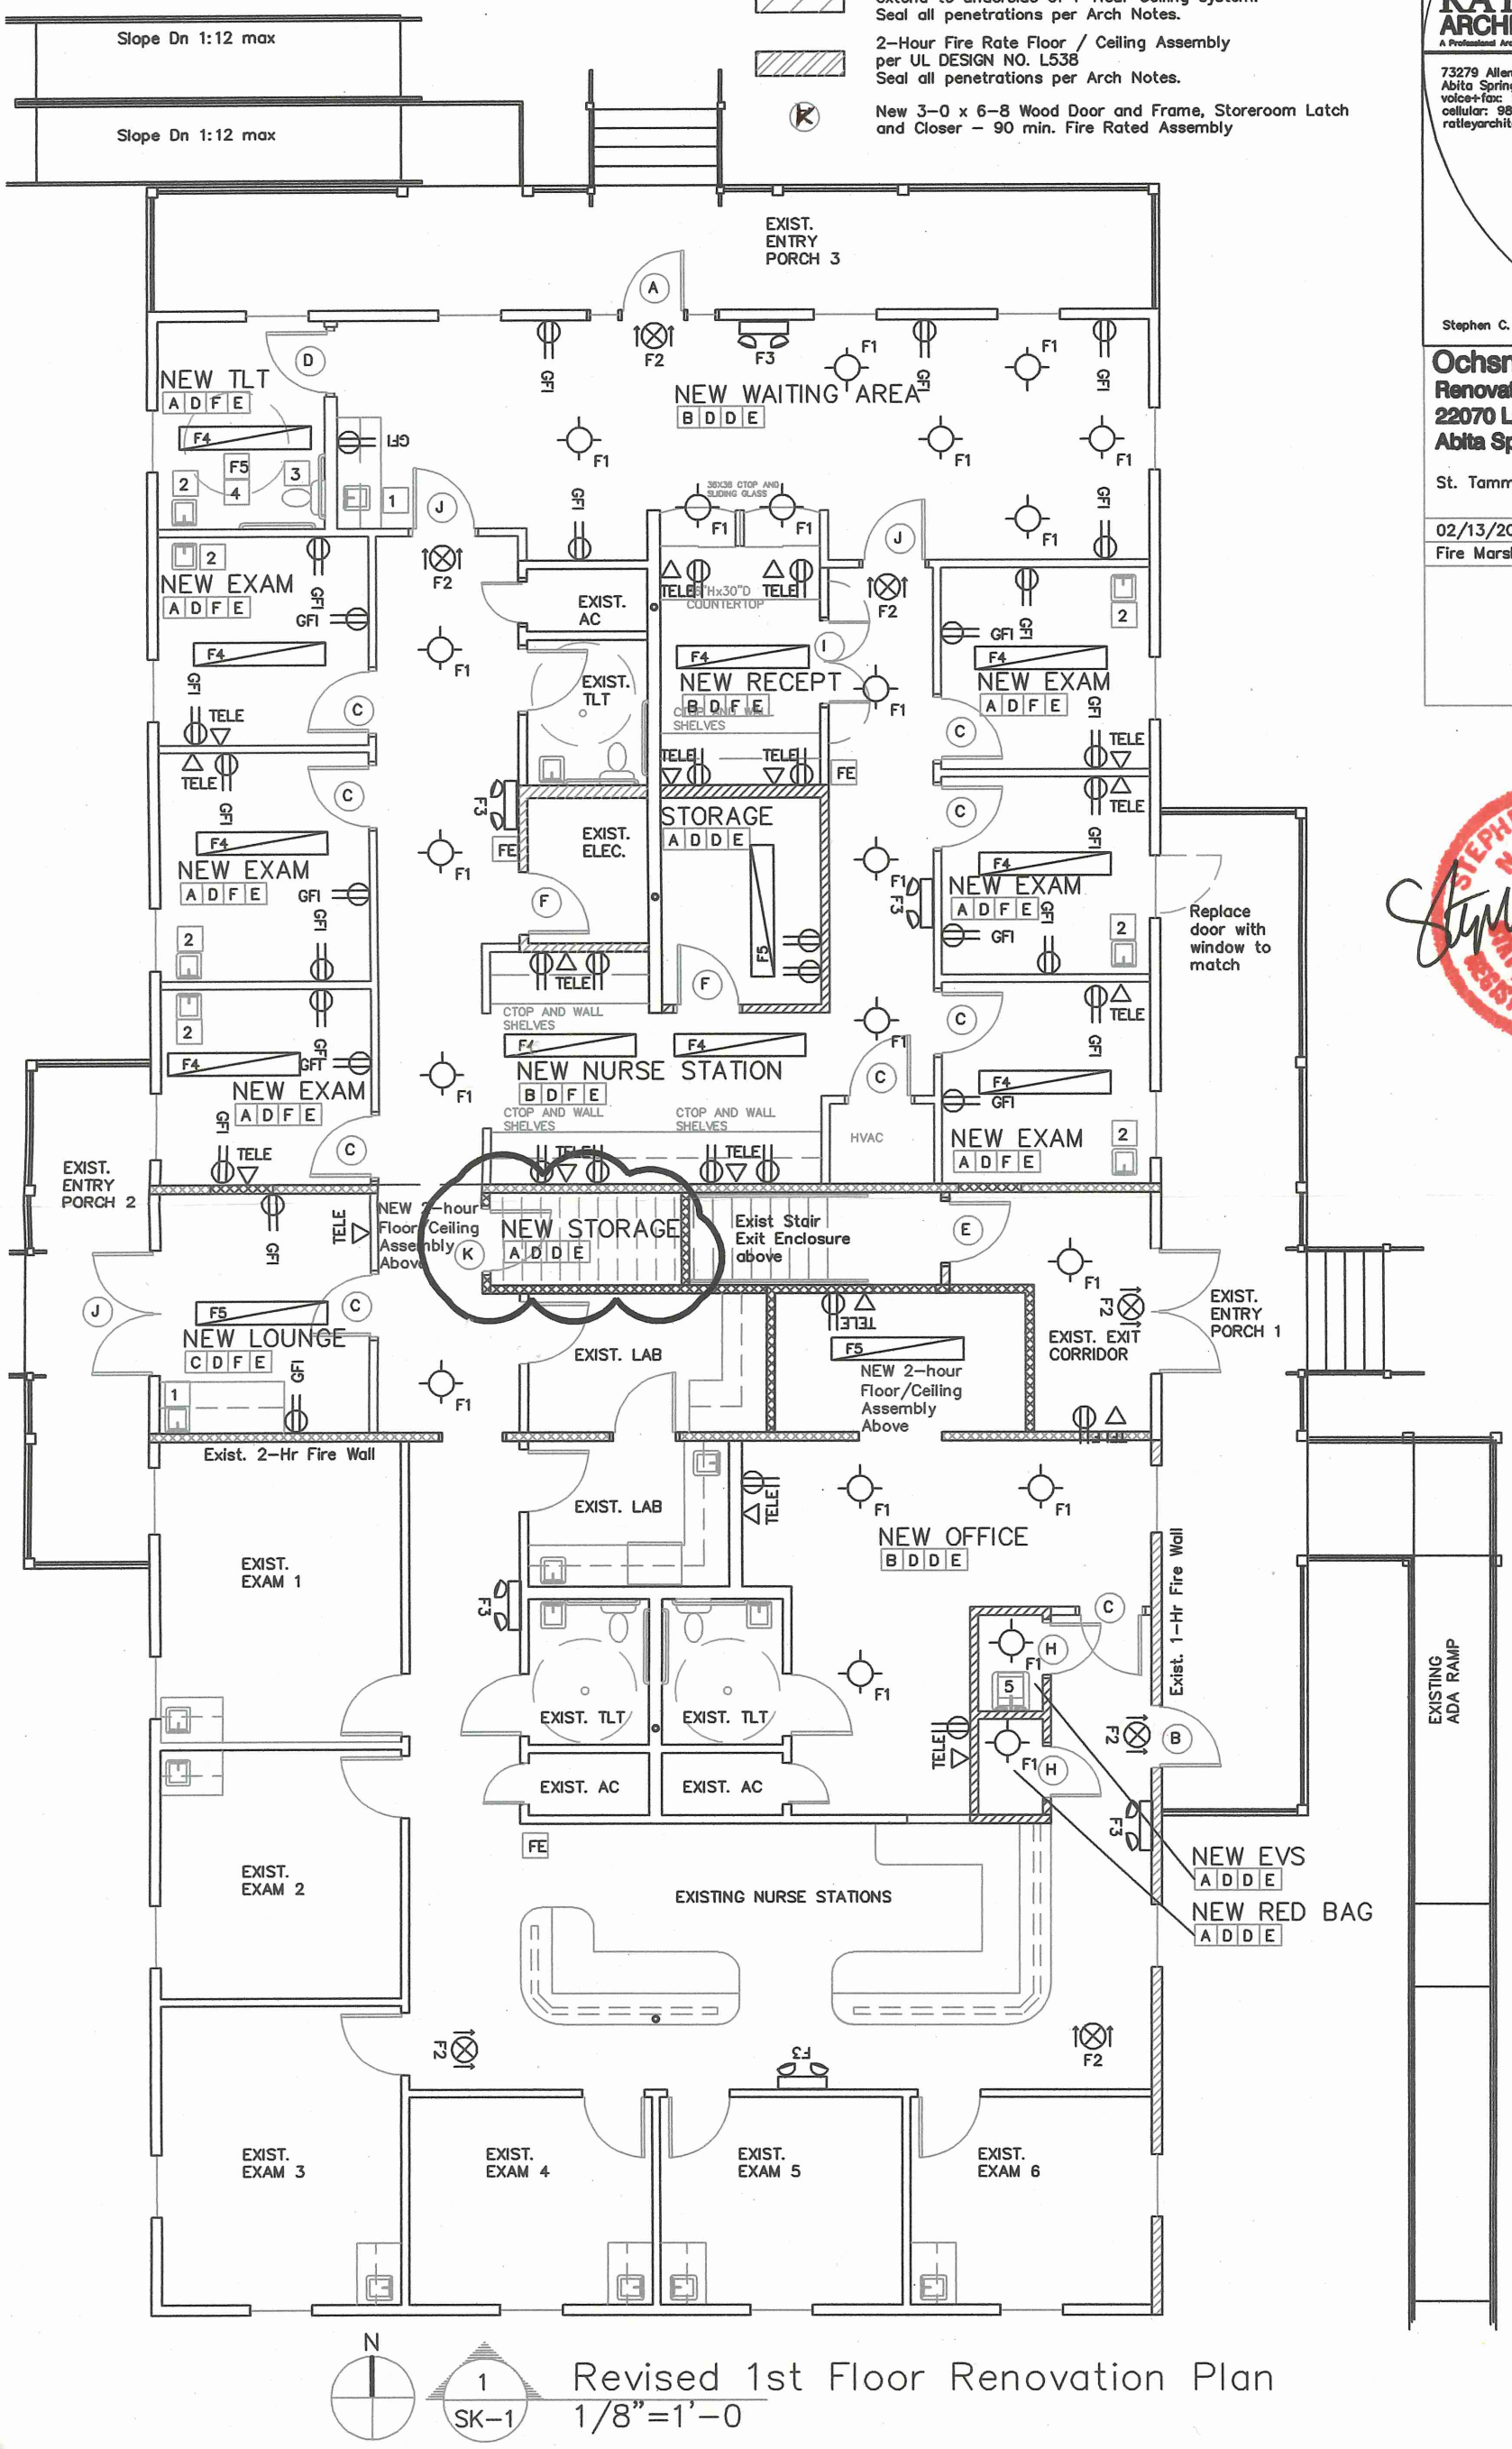

N

1
SK-1

Revised 1st Floor Renovation Plan
1/8"=1'-0

RATLEY ARCHITECTS
A Professional Architectural Corporation

73279 Allen Road
Abita Springs LA 70420
voice+fax: 985.867.9509
cellular: 985.630.9682
ratleyarchitects @ bellsouth.net

Stephen C. Ratley, AIA

Ochsner Clinic
Renovations and Additions
22070 La Hwy 59
Abita Springs, LA 70420

St. Tammany Parish

02/13/2010	2004-20
Fire Marshal	Ochsner4.dwg

SK-1

STEPHEN C. RATLEY No. 3107 STATE OF LOUISIANA REGISTERED ARCHITECT