


MAP

OF $3\frac{1}{2}$ A. IN NW $\frac{1}{4}$ OF S.E. $\frac{1}{4}$ OF N.E. $\frac{1}{4}$
SECTION 36 T. 6 S. R. 7 E.

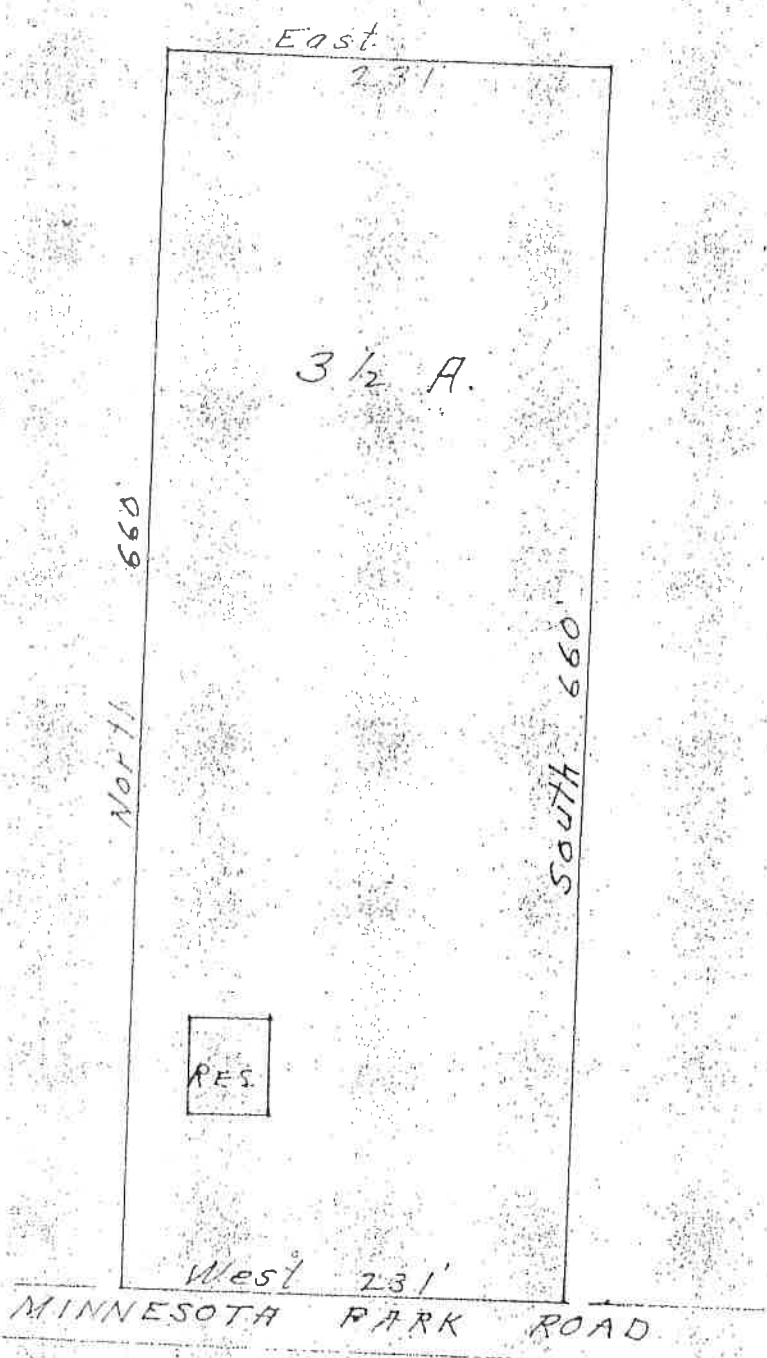

Scale 100 feet to inch. Aug 11th 1951.
I hereby certify the above map to be correct.
E. M. Moore, Reg. C. E. & Surveyor