



\$913760

April 26, 2000

Mr. Ray St. Pierre  
R & S Auto Service, Inc.  
519 Hagan  
New Orleans, LA 70119


Re: Underground Storage Tanks (USTs)  
R & S Auto Service, Inc.  
519 Hagan  
New Orleans, LA

Dear Mr. St. Pierre:

Please find enclosed the revised proposal for the removal of the USTs at the above-mentioned site. I look forward to providing this service to you.

If you have any questions, please call me at 1-888-558-5151.

Sincerely,

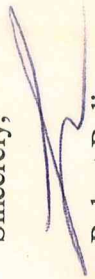  
Robert Bolin  
Ranger Environmental, Inc.

RB/tlc



October 3, 2000

Mr. Ray St. Pierre  
R & S Auto Service  
519 Hagan Street  
New Orleans, LA 70119

RE: Underground Storage Tank (UST) Closure  
R & S Auto Service  
519 Hagan Street  
New Orleans, LA

Dear Mr. St. Pierre:

Please find enclosed copies of the paperwork that was filed with the Department of Environmental Quality (DEQ) for the removal of the USTs at the above-referenced site. Please keep these documents for future reference. You will receive a copy of the Closure/Assessment form from the DEQ upon completion of processing your paperwork.

If you have any questions, please call me at 1-800-264-0805. We appreciate your business and look forward to working with you in the future.

Sincerely,

Teresa Covington  
Ranger Environmental, Inc.



April 4, 2000

Mr. Ray St. Pierre  
R & S Auto Service, Inc.  
519 Hagan  
New Orleans, LA 70119

RE: Underground Storage Tanks (USTs)  
R & S Auto Service, Inc.  
519 Hagan  
New Orleans, LA 70119

Dear Mr. St. Pierre:

Per our conversation, enclosed is a proposal for the removal of the underground fuel tanks located on your property. As noted on the proposal, the fluids will be removed at cost. International Oil Service usually charges \$.25 a gallon for large volumes of fluids. However since you have an account with them, you may be able to get it for less. The fluid cost will add about \$1,500.00 to the cost of the project (\$.25 X 6,000 gallons = \$1,500.00) (if the tanks are full). The tanks appear to be under the shed in front of the building. The shed should not be in the way, but one or two of the poles will need to be removed. These poles can be used to brace up the shed until we get ready to replace the concrete. These tanks do not appear to be registered with the Department of Environmental Quality (DEQ). I have enclosed Registration and Closure Notification forms for your signature. I would appreciate the opportunity to work with you on this project. If you have any questions, please call me direct at 1-888-558-5151.

Sincerely,

  
Robert Bolin  
Ranger Environmental, Inc.

RB/tlc

Enclosures: Proposal, Registration, Closure Notification

P. O. BOX 1402    ⊕    MANDEVILLE, LA 70470    ⊕    504-727-7090    ⊕    FAX 1-800-477-5189  
504-243-0609    ⊕    NEW ORLEANS, LA    ⊕    1-800-264-0805    ⊕    SHREVEPORT, LA

**“WE’RE HERE TO HELP”**

# UNDERGROUND STORAGE TANK DIVISION SITE DRAWING FORM

**Name of Site:** R & S Auto Service

Parish: Orleans


Facility Identification No. 36-017976



North

| Total Number of Samples Collected - 5 |   |
|---------------------------------------|---|
| 1                                     | 1 |
| 2                                     | 1 |
| 3                                     | 1 |
| 4                                     | 1 |
| 5                                     | 1 |

Approximate Scale (in feet)

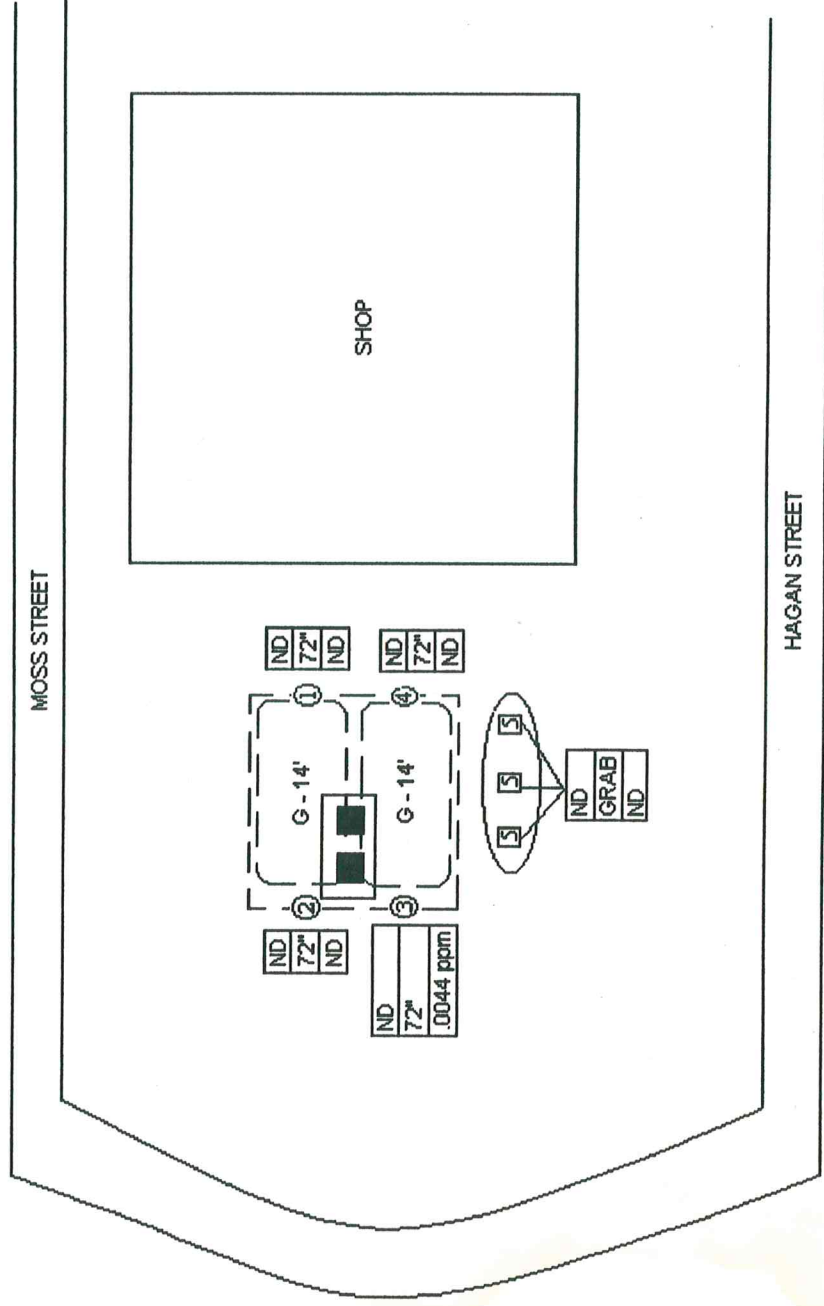

|       |                          |
|-------|--------------------------|
| 2.435 | Results of TPH - U (ppm) |
| 22"   | Depth of Sample          |

|       |                             |
|-------|-----------------------------|
| 1117  | Results of TPH-G (ppm)      |
| 24"   | Depth of Sample             |
| 1.487 | Results of Total BTEX (ppm) |

|       |                        |
|-------|------------------------|
| 2.435 | Results of TPH-D (ppm) |
| 22"   | Depth of Sample        |

① Indicates Assigned Sample No. and Sample Location  
Groundwater Encountered During Sampling

3

Indicates Assigned Sample No.  
Groundwater NOT Encountered

Removed UST

## Closed-In-Place UST

D - 27 ft. Tank Contained Diesel and length of tank  
G - 27 ft. Tank Contained Gasoline and length of tank  
U - 5 ft. Tank Contained Used Oil and length of tank

## Excavated Soils to be Returned to Hole

ND - None Detectable

☐ **Dispenser Island**

## Dispenser

**Tank Hold Area**

ND - None Detectable