



REFERENCE DATA:

I. FINAL PLAT OF PARK EASTBANK, FIRST FILING...
BY R. JAMES TATUM, P.E. & P.L.S. DATED 3-06-01

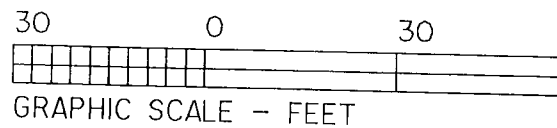

EASTBANK DRIVE

(60' R/W)

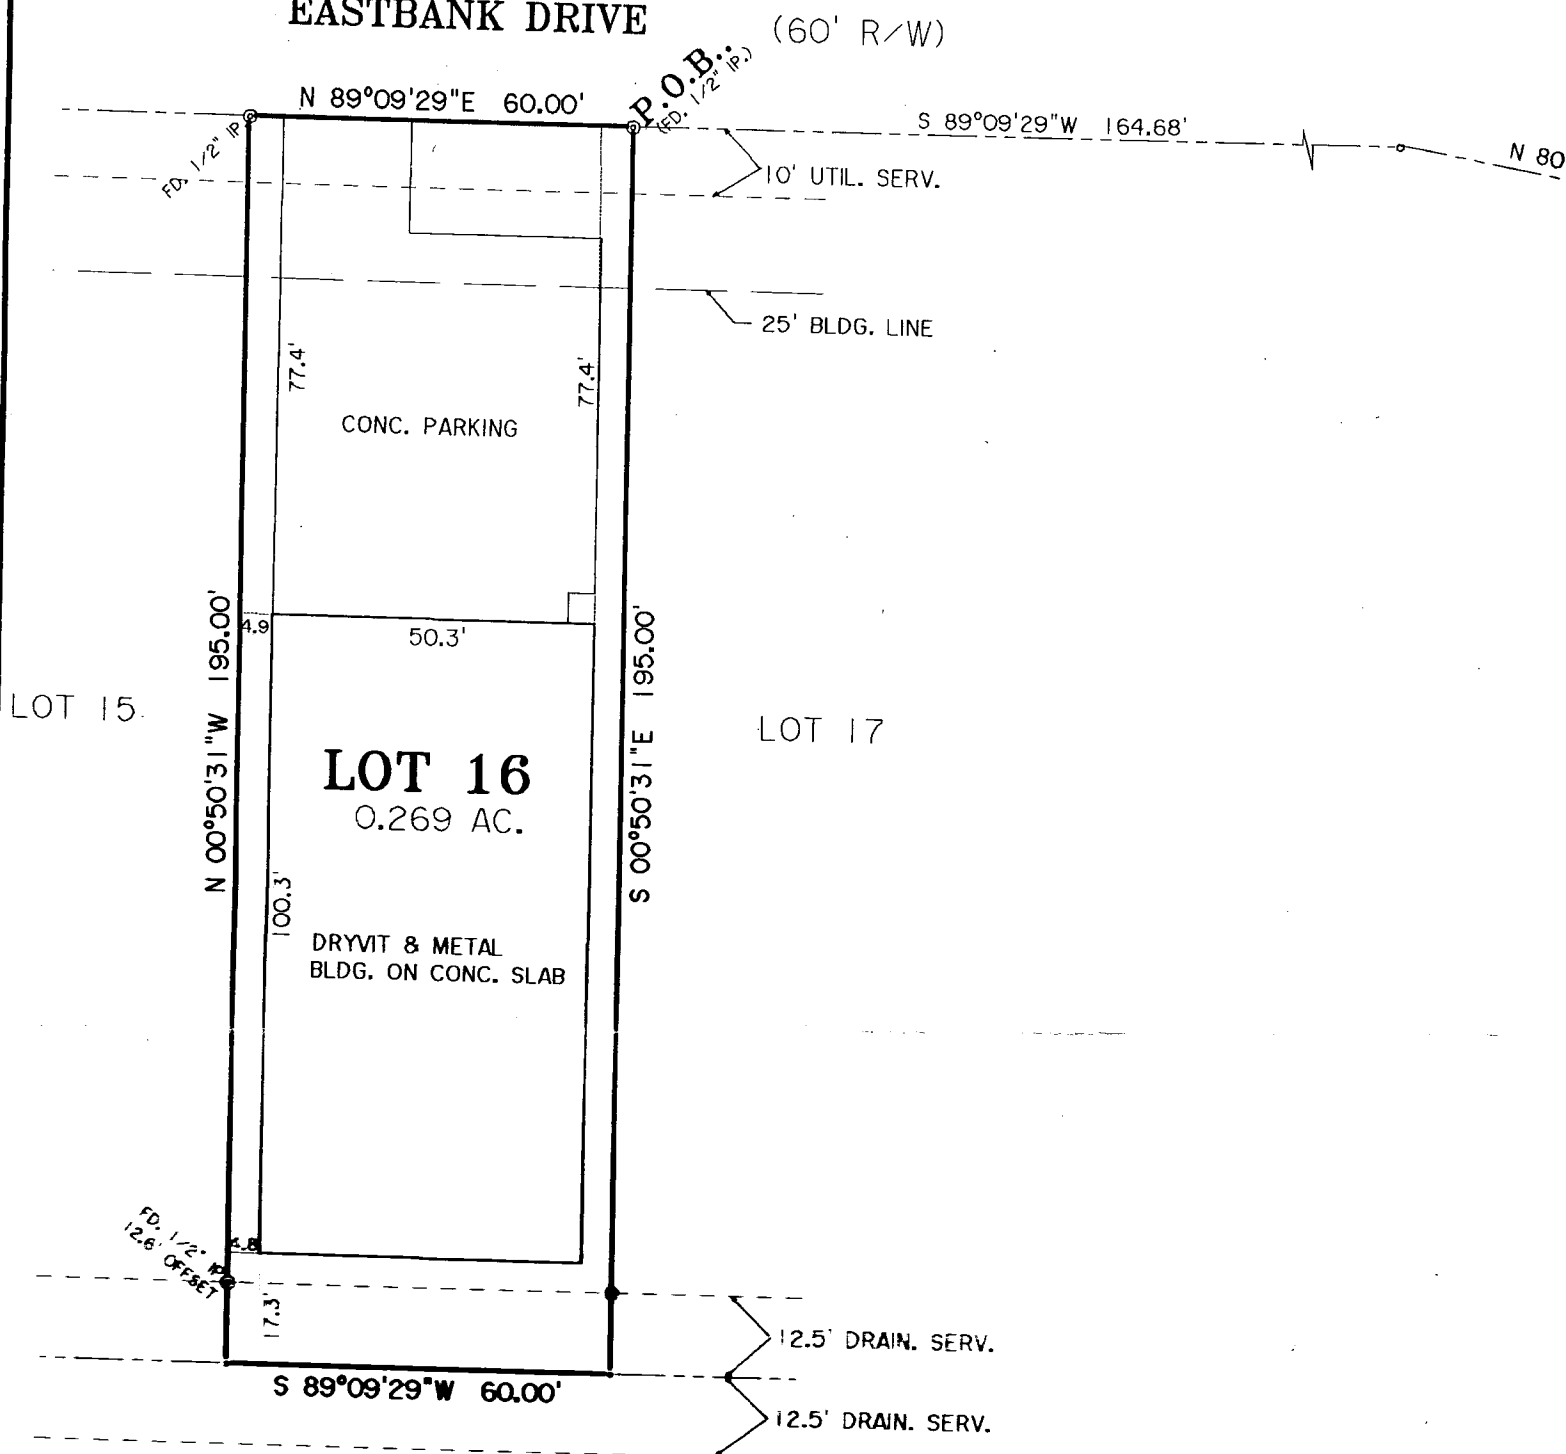

TRACT PE-2-3