
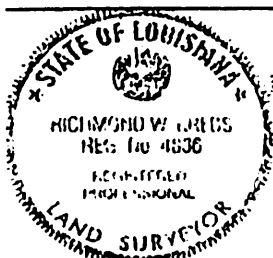


**BOUNDARY SURVEY OF
LOT 6 AND THE NORTH HALF OF LOT 7
SQUARE 19
PEARL ACRES
ST. TAMMANY PARISH, LA
WEST BOUNDARY OF SUBDIVISION**

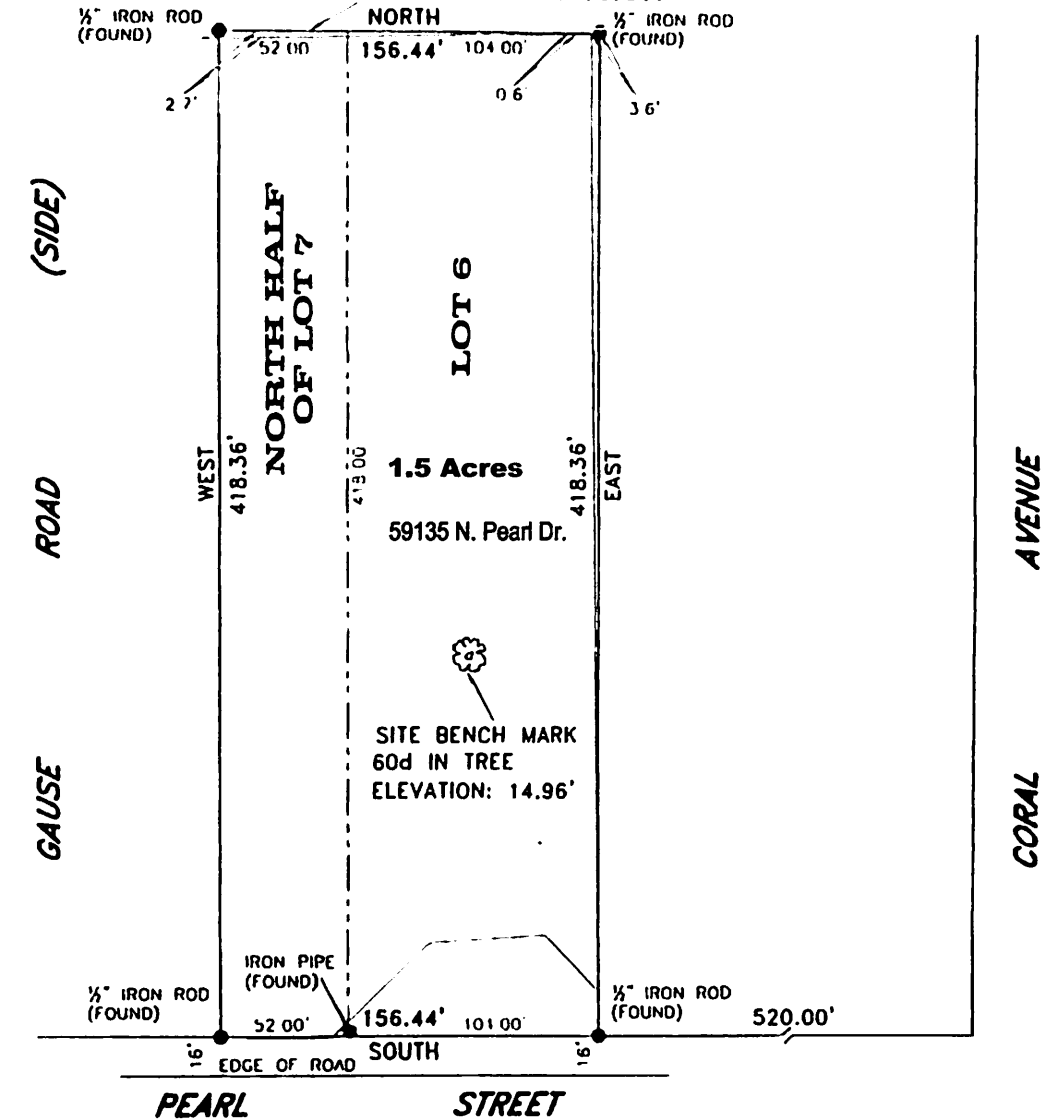

THIS IS TO CERTIFY THAT THE PROPERTY BOUNDARY SURVEY RECORDED HEREON WAS MADE ON THE GROUND UNDER MY DIRECT SUPERVISION AND IS IN ACCORDANCE WITH APPLICABLE STANDARDS OF PRACTICE FOR PROFESSIONAL LAND SURVEYORS AS STIPULATED IN LOUISIANA REPRODUCTION CODE TITLE 46:21, CHAPTER 25 FOR A CLASS "C" (SUBORDINATE) SURVEY.

MADE AT THE REQUEST OF PEARL INVESTMENTS, LLC

BY *Richmond W. Krebs*

GENERAL NOTES

ANGLES AND/OR BEARINGS ARE BASED ON REFERENCE PLAN #1
REFERENCE PLAN 1 PLAN OF SURVEY BY ALBERT A. LOVELL & ASSOCIATES INC. DATED NOVEMBER 15, 1994
THE SEPARATES SHOWN ON THIS SURVEY ARE LIMITED TO THOSE FURNISHED US AND THERE IS NO REPRESENTATION THAT ALL APPLICABLE SEPARATES ARE REFLECTED OR SHOWN HEREON. THE SURVEYOR HAS MADE NO TITLE SEARCH OR PUBLIC RECORD SEARCH IN COMPILING THE DATA FOR THIS SURVEY.
THIS PERIMETER SURVEY SHALL NOT CONSTITUTE A LEGAL OPINION OF TITLE AND SHALL NOT BE RELIED UPON FOR THAT PURPOSE. THERE IS NO WARRANTY THAT IT CONFORMS TO THE LEGAL TITLE, AND WAS MADE SOLELY ACCORDING TO THE INFORMATION PROVIDED THE SURVEYOR.

ELEVATION NOTES

THIS IS TO CERTIFY THAT SUBJECT PROPERTY IS LOCATED IN THE FOLLOWING FLOOD ZONE PER FLOOD INSURANCE RATE MAP (FIRM) DATED APRIL 21, 1999 FLOOD ZONE "C"
BASE FLOOD ELEVATION: 11.74 COMMUNITY PANEL # 225205 0440 D

**RICHMOND W. KREBS
PROFESSIONAL LAND SURVEYING**

P.O. BOX 8641

METairie, LA. 70011-8641

PHONE: (504) 889-0818

FAX: (504) 889-0918

E-MAIL: richmondwk@krebssurvey.com

DATE: JANUARY 31, 2006

SCALE: 1" = 60'

JOB # 060158

DRAWN BY: R.W.K.

COMPUTER: /

FILE #