



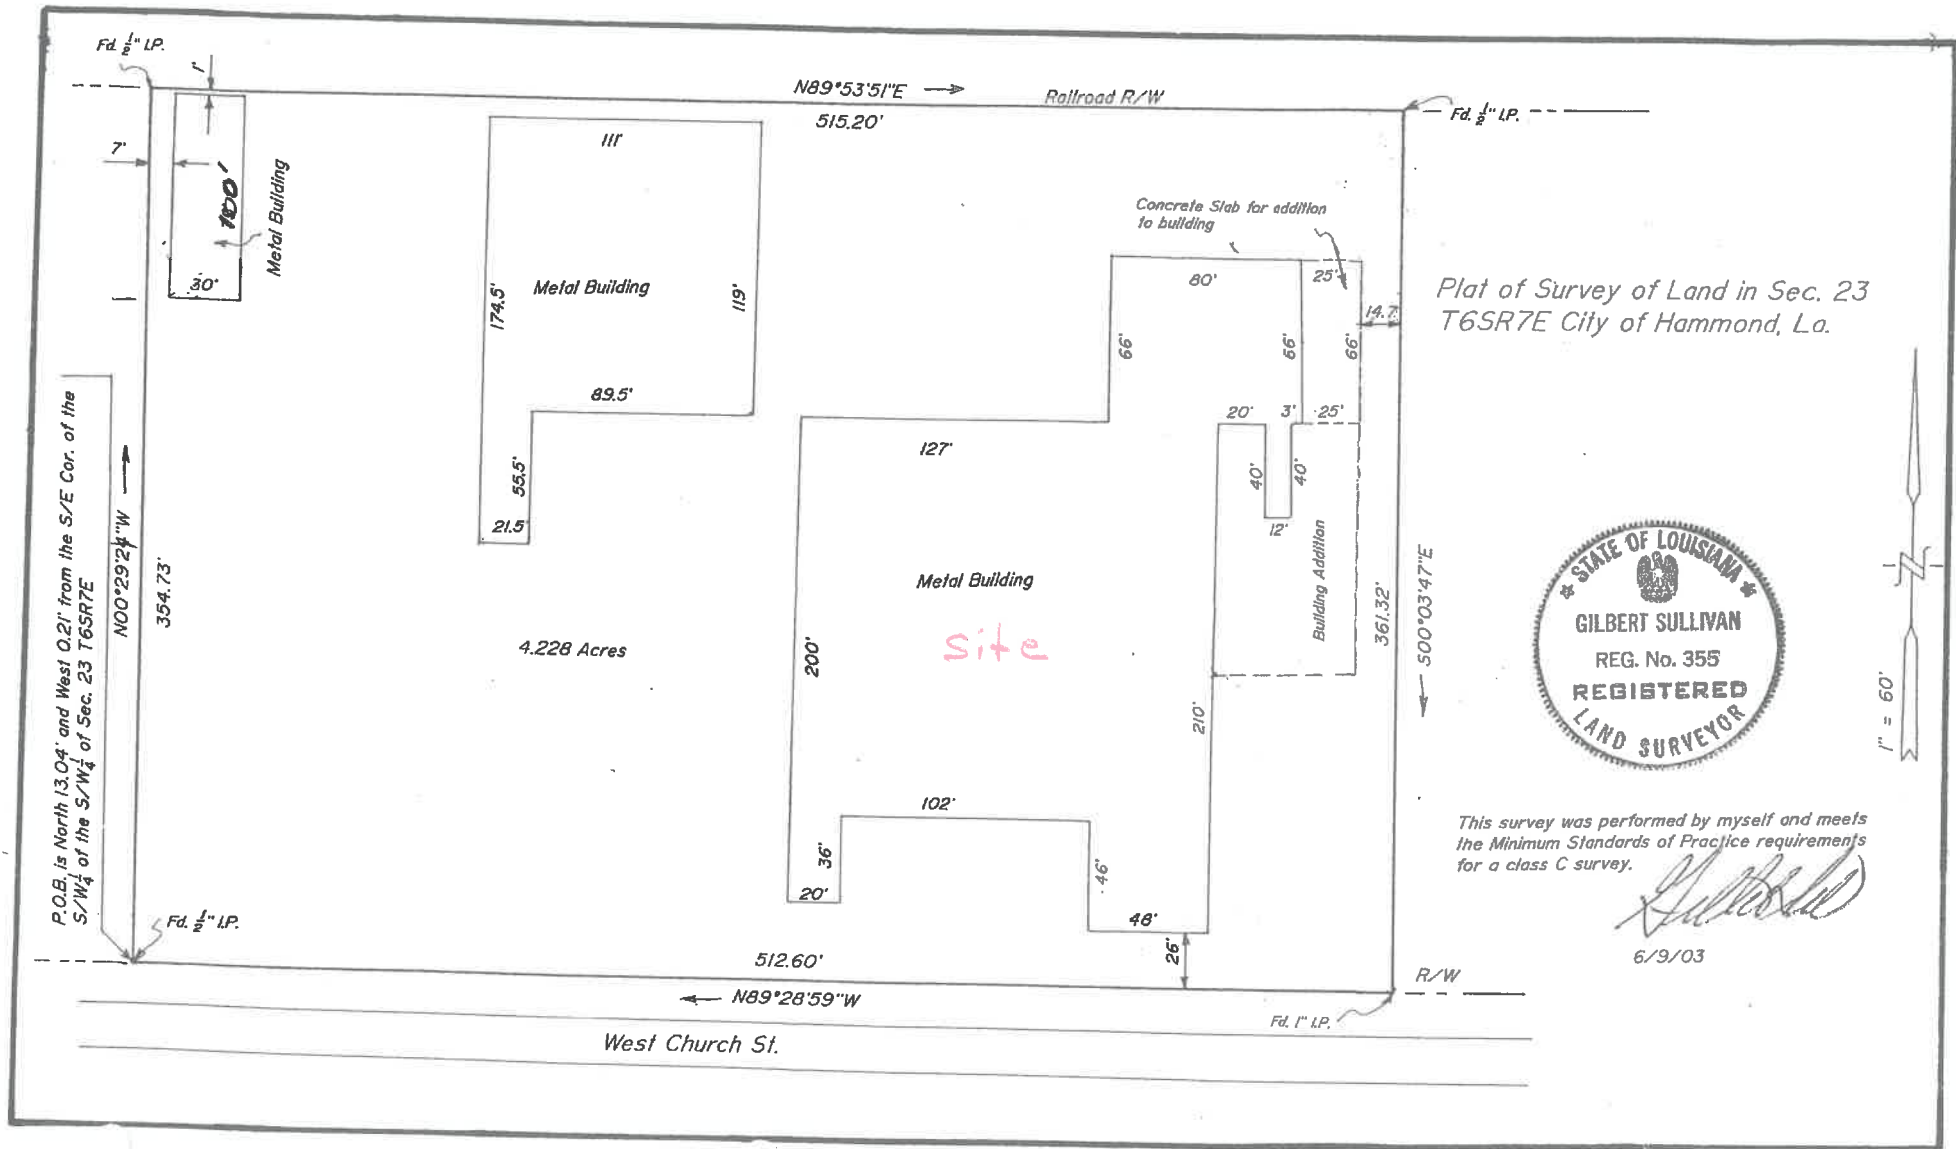

This survey was performed by myself and meets the Minimum Standards of Practice requirements for a class C survey.

*Gilbert Sullivan*

6/9/03

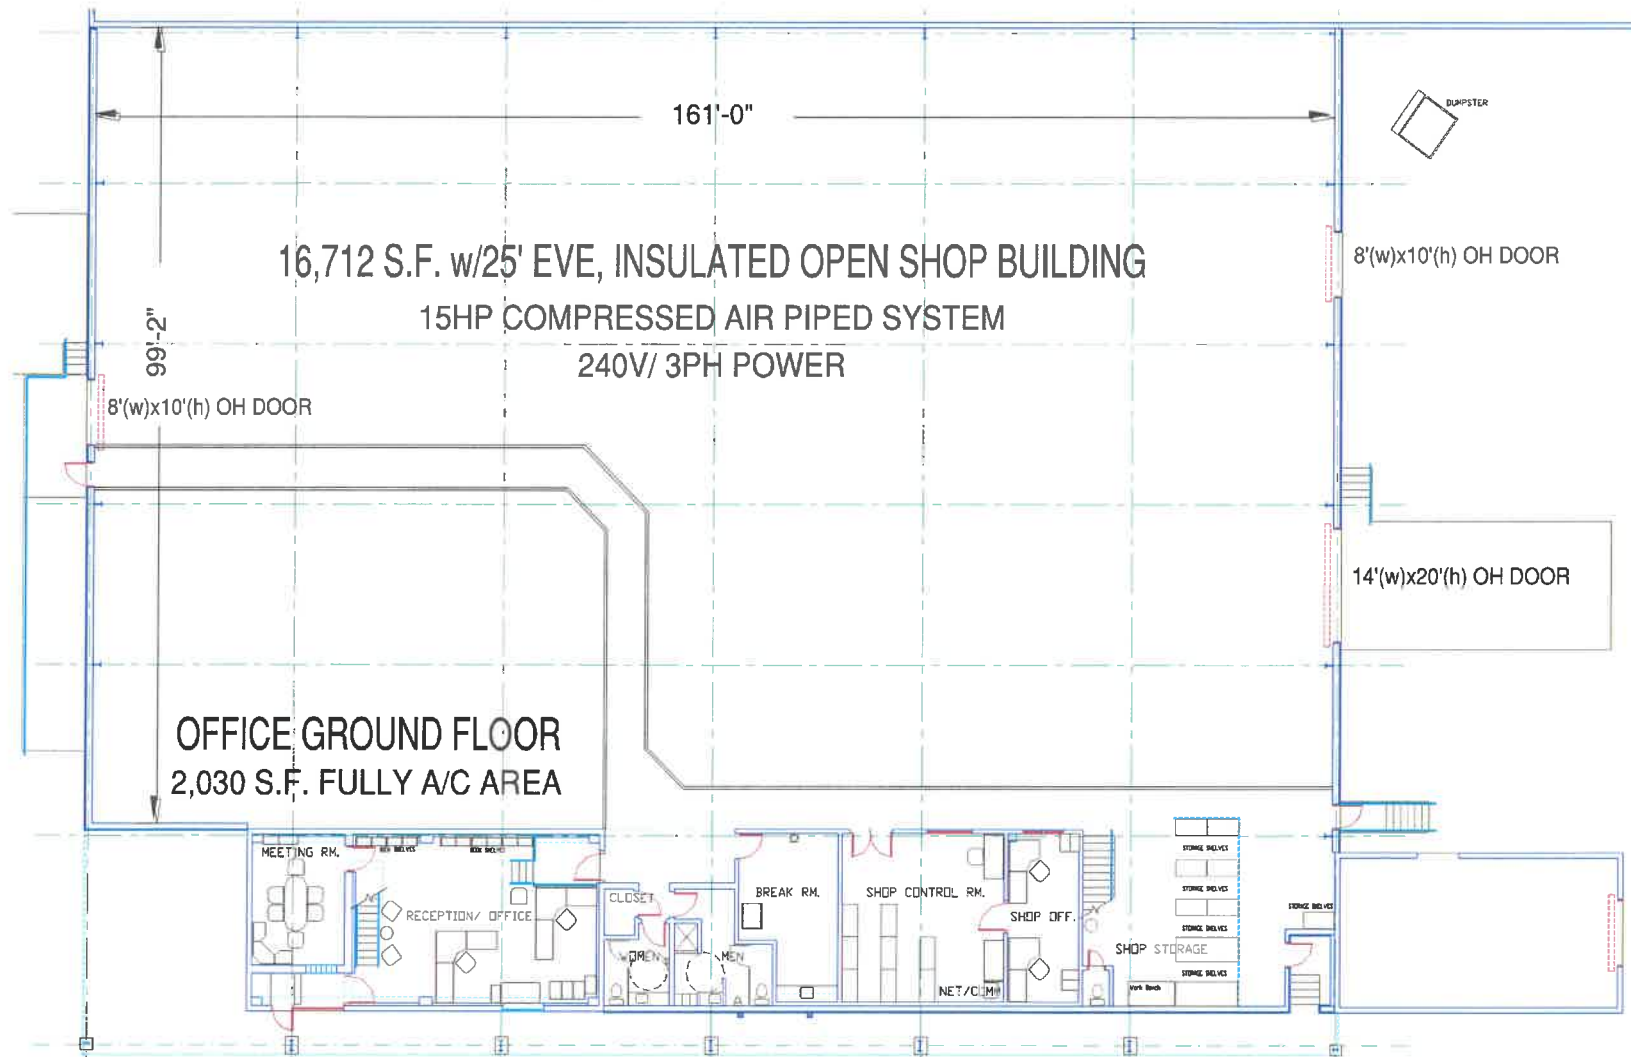

1700 West Church St. Suite "C", Hammond, Louisiana 70401

APPROX 20,800 SQ FT.

