


19+18

FARM LOTS 17 AND 18
MARVIS GROVE SUBDIVISION
JEFFERSON PARISH, LA

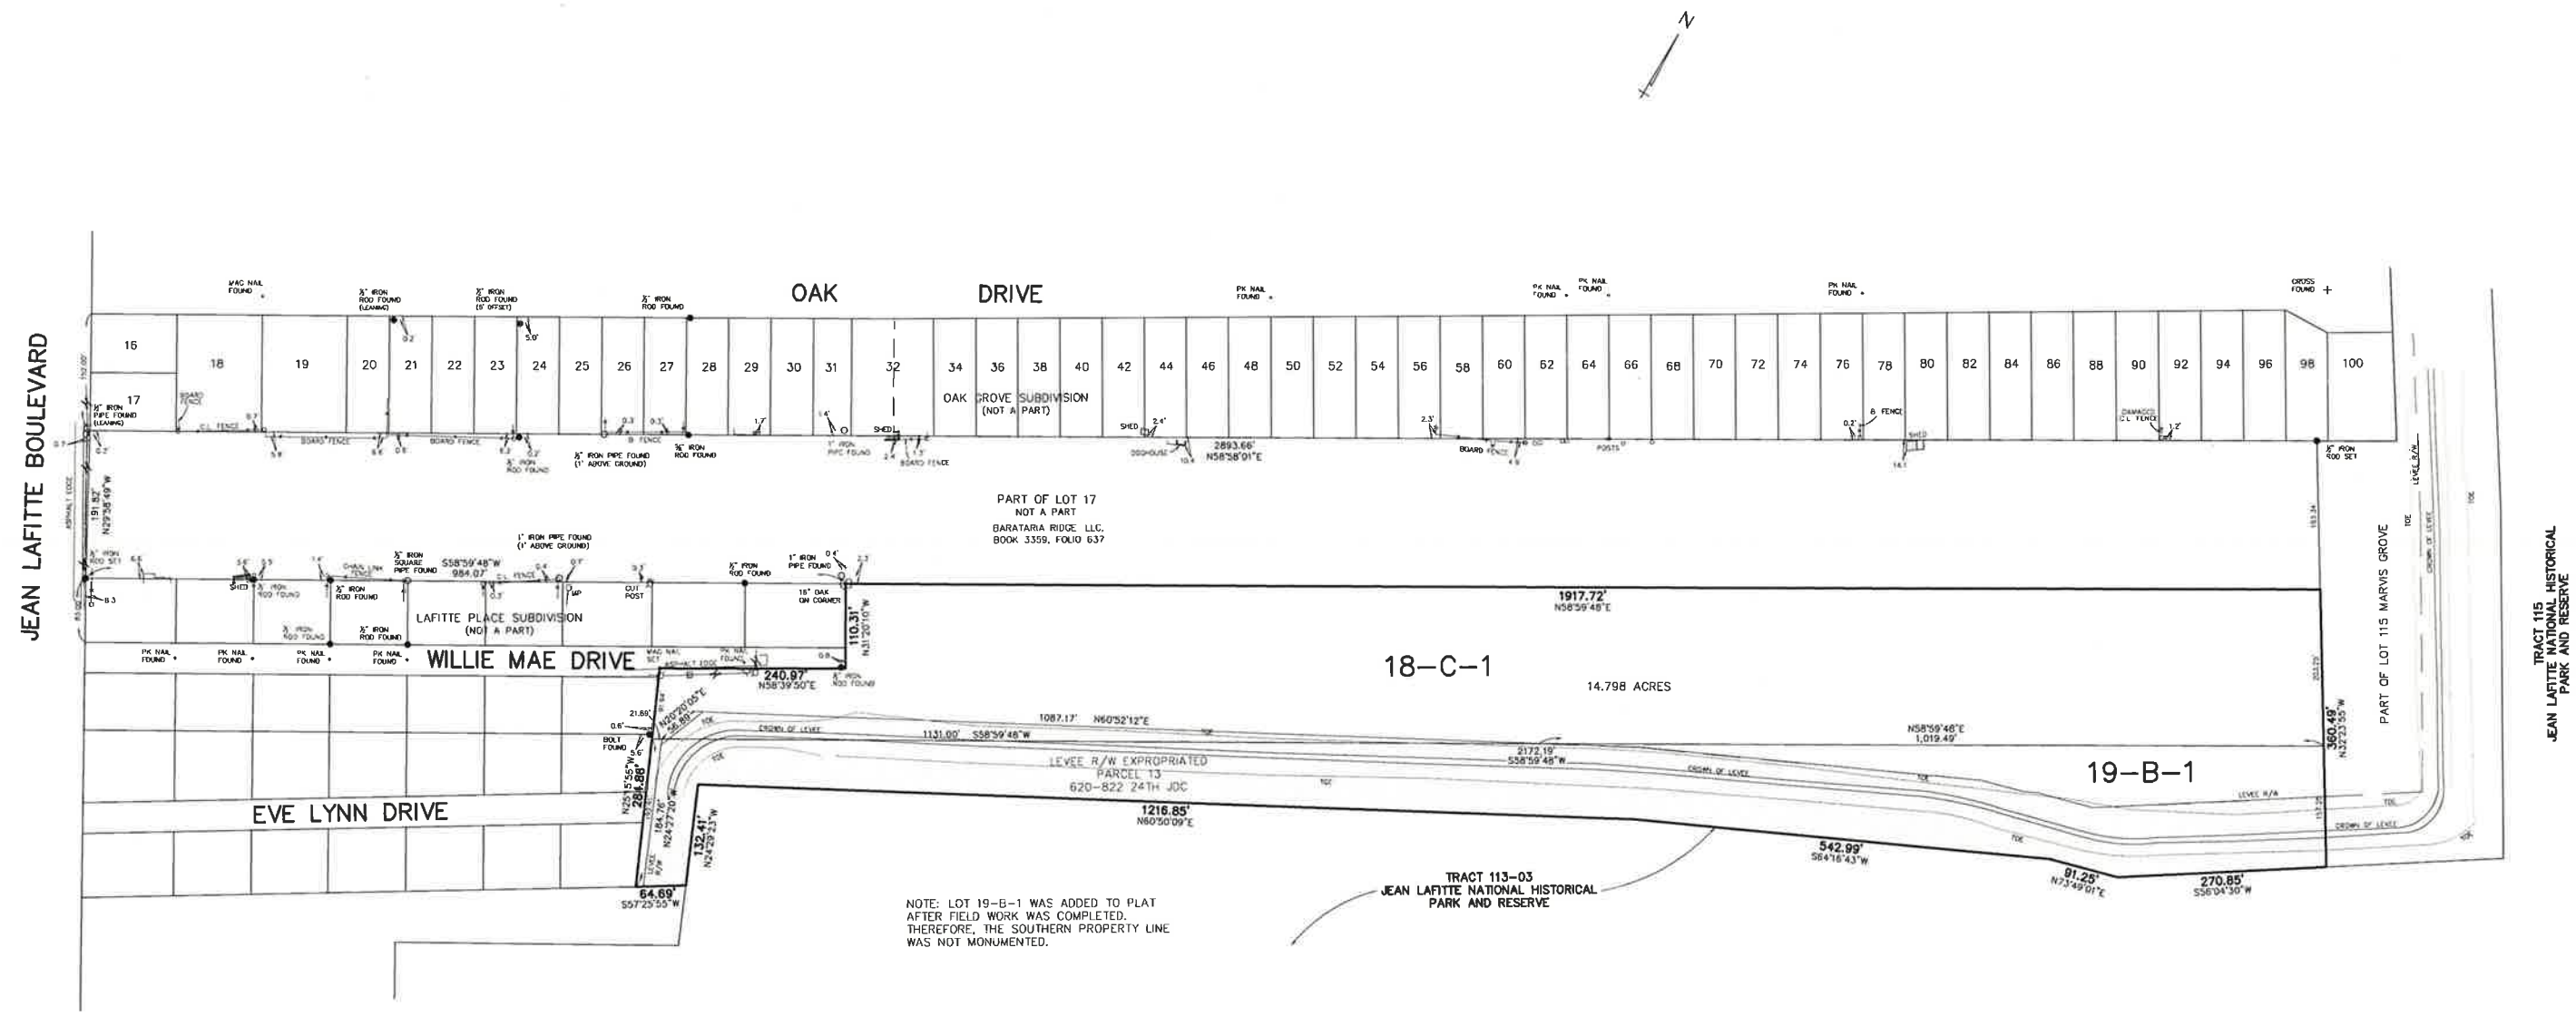

NOTE: LOT 19-B-1 WAS ADDED TO PLAT
AFTER FIELD WORK WAS COMPLETED.
THEREFORE, THE SOUTHERN PROPERTY LINE
WAS NOT MONUMENTED.

LEGEND
OVERHEAD UTILITY LINES
SQUARE DRAIN INLET
FIRE HYDRANT
POWER POLE
ANCHOR/POLE WIRE
ELECTRIC METER POLE
ROUND FENCE POST
SQUARE FENCE POST

100 50 0 50 100
SCALE IN FEET

BEARINGS ARE BASED ON THE LOUISIANA
COORDINATE SYSTEM OF 1983, SOUTH ZONE
BASED ON GPS OBSERVATIONS.

THE SERVICES AND RESTRICTIONS SHOWN ON THIS SURVEY ARE LIMITED
TO THOSE SET FORTH IN THE DESCRIPTION FURNISHED TO US AND THERE IS
NO REPRESENTATION THAT ALL APPLICABLE SERVITUDES AND RESTRICTIONS
ARE SHOWN HEREON. THE SURVEYOR HAS MADE NO TITLE SEARCH OR
PUBLIC RECORD SEARCH IN COMPILING THE DATA FOR THIS SURVEY.

REFERENCES:
-RECONSTRUCTION OF A PORTION OF LOTS 18-C-1, 19-B-1, 19-B-2, 19-B-3, 

Beth Cristina, ALC

From: JP Fleming <jpfcofleminghill@aol.com>
Sent: Thursday, May 12, 2022 3:16 PM
To: Beth Cristina, ALC
Subject: Fleming Plantation farm lots 18 and 19
Attachments: T-6231-L(042122) farm lots 18+19.pdf

Caution, External Email – Please verify the legitimacy of this email.

Beth,
another possible commercial development to place on market
note survey is for 18 and 19 NOT 17 and 18 as noted

Jay Dufrene will be providing a formal survey of Farm Lot 1 due to Timmy Danos financing part of the sale with the lot

jpfcofleminghill@aol.com