



J.P. Vanway
1D
189006
190176

EXISTING WELL AS-DRILLED POSITION	
X=	3,367,789.56' (83)
Y=	684,275.03' (83)
Lat=	30°22'52.768"N
Lon=	91°03'27.227"W
X=	2,086,990.81' (27)
Y=	623,566.49' (27)

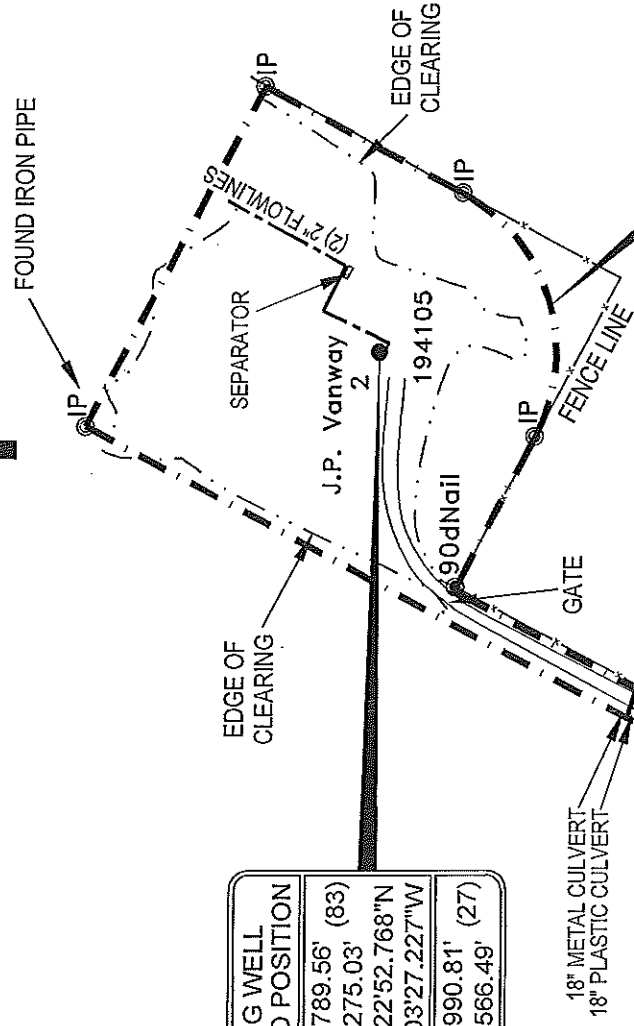


EXISTING WELL SITE
AND ACCESS
CALLED 2.932 ACRES

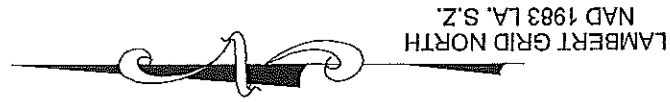


Goldking
166967

PLAN

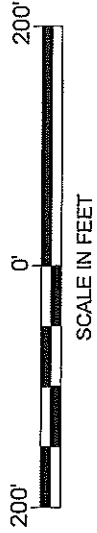

PRELIMINARY

THIS DOCUMENT SHALL NOT BE RECORDED FOR ANY PURPOSE

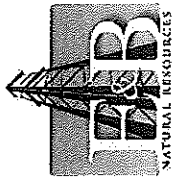

E & B Natural Resources

1600 Norris Road
Bakersfield, California 93308

EXISTING WELL SITE - PECUE NO. 2
T8S-R1E & 2E- GREENSBURG LAND DISTRICT
SIEGEN FIELD
EAST BATON ROUGE PARISH, LOUISIANA

PREPARED
BY

C&C Technologies
SURVEY SERVICES
730 E. KALISTE SALOOM ROAD, LAFAYETTE, LA 70503
LA. REGISTRATION NUMBER: 330

JOB NO. 140875
DWG: JMT
FILENAME: L:\07501EE\140875\140875.DWG

CHK: GP

REVISED:

DATE: 7/28/2014

SHEET 1 OF 1