
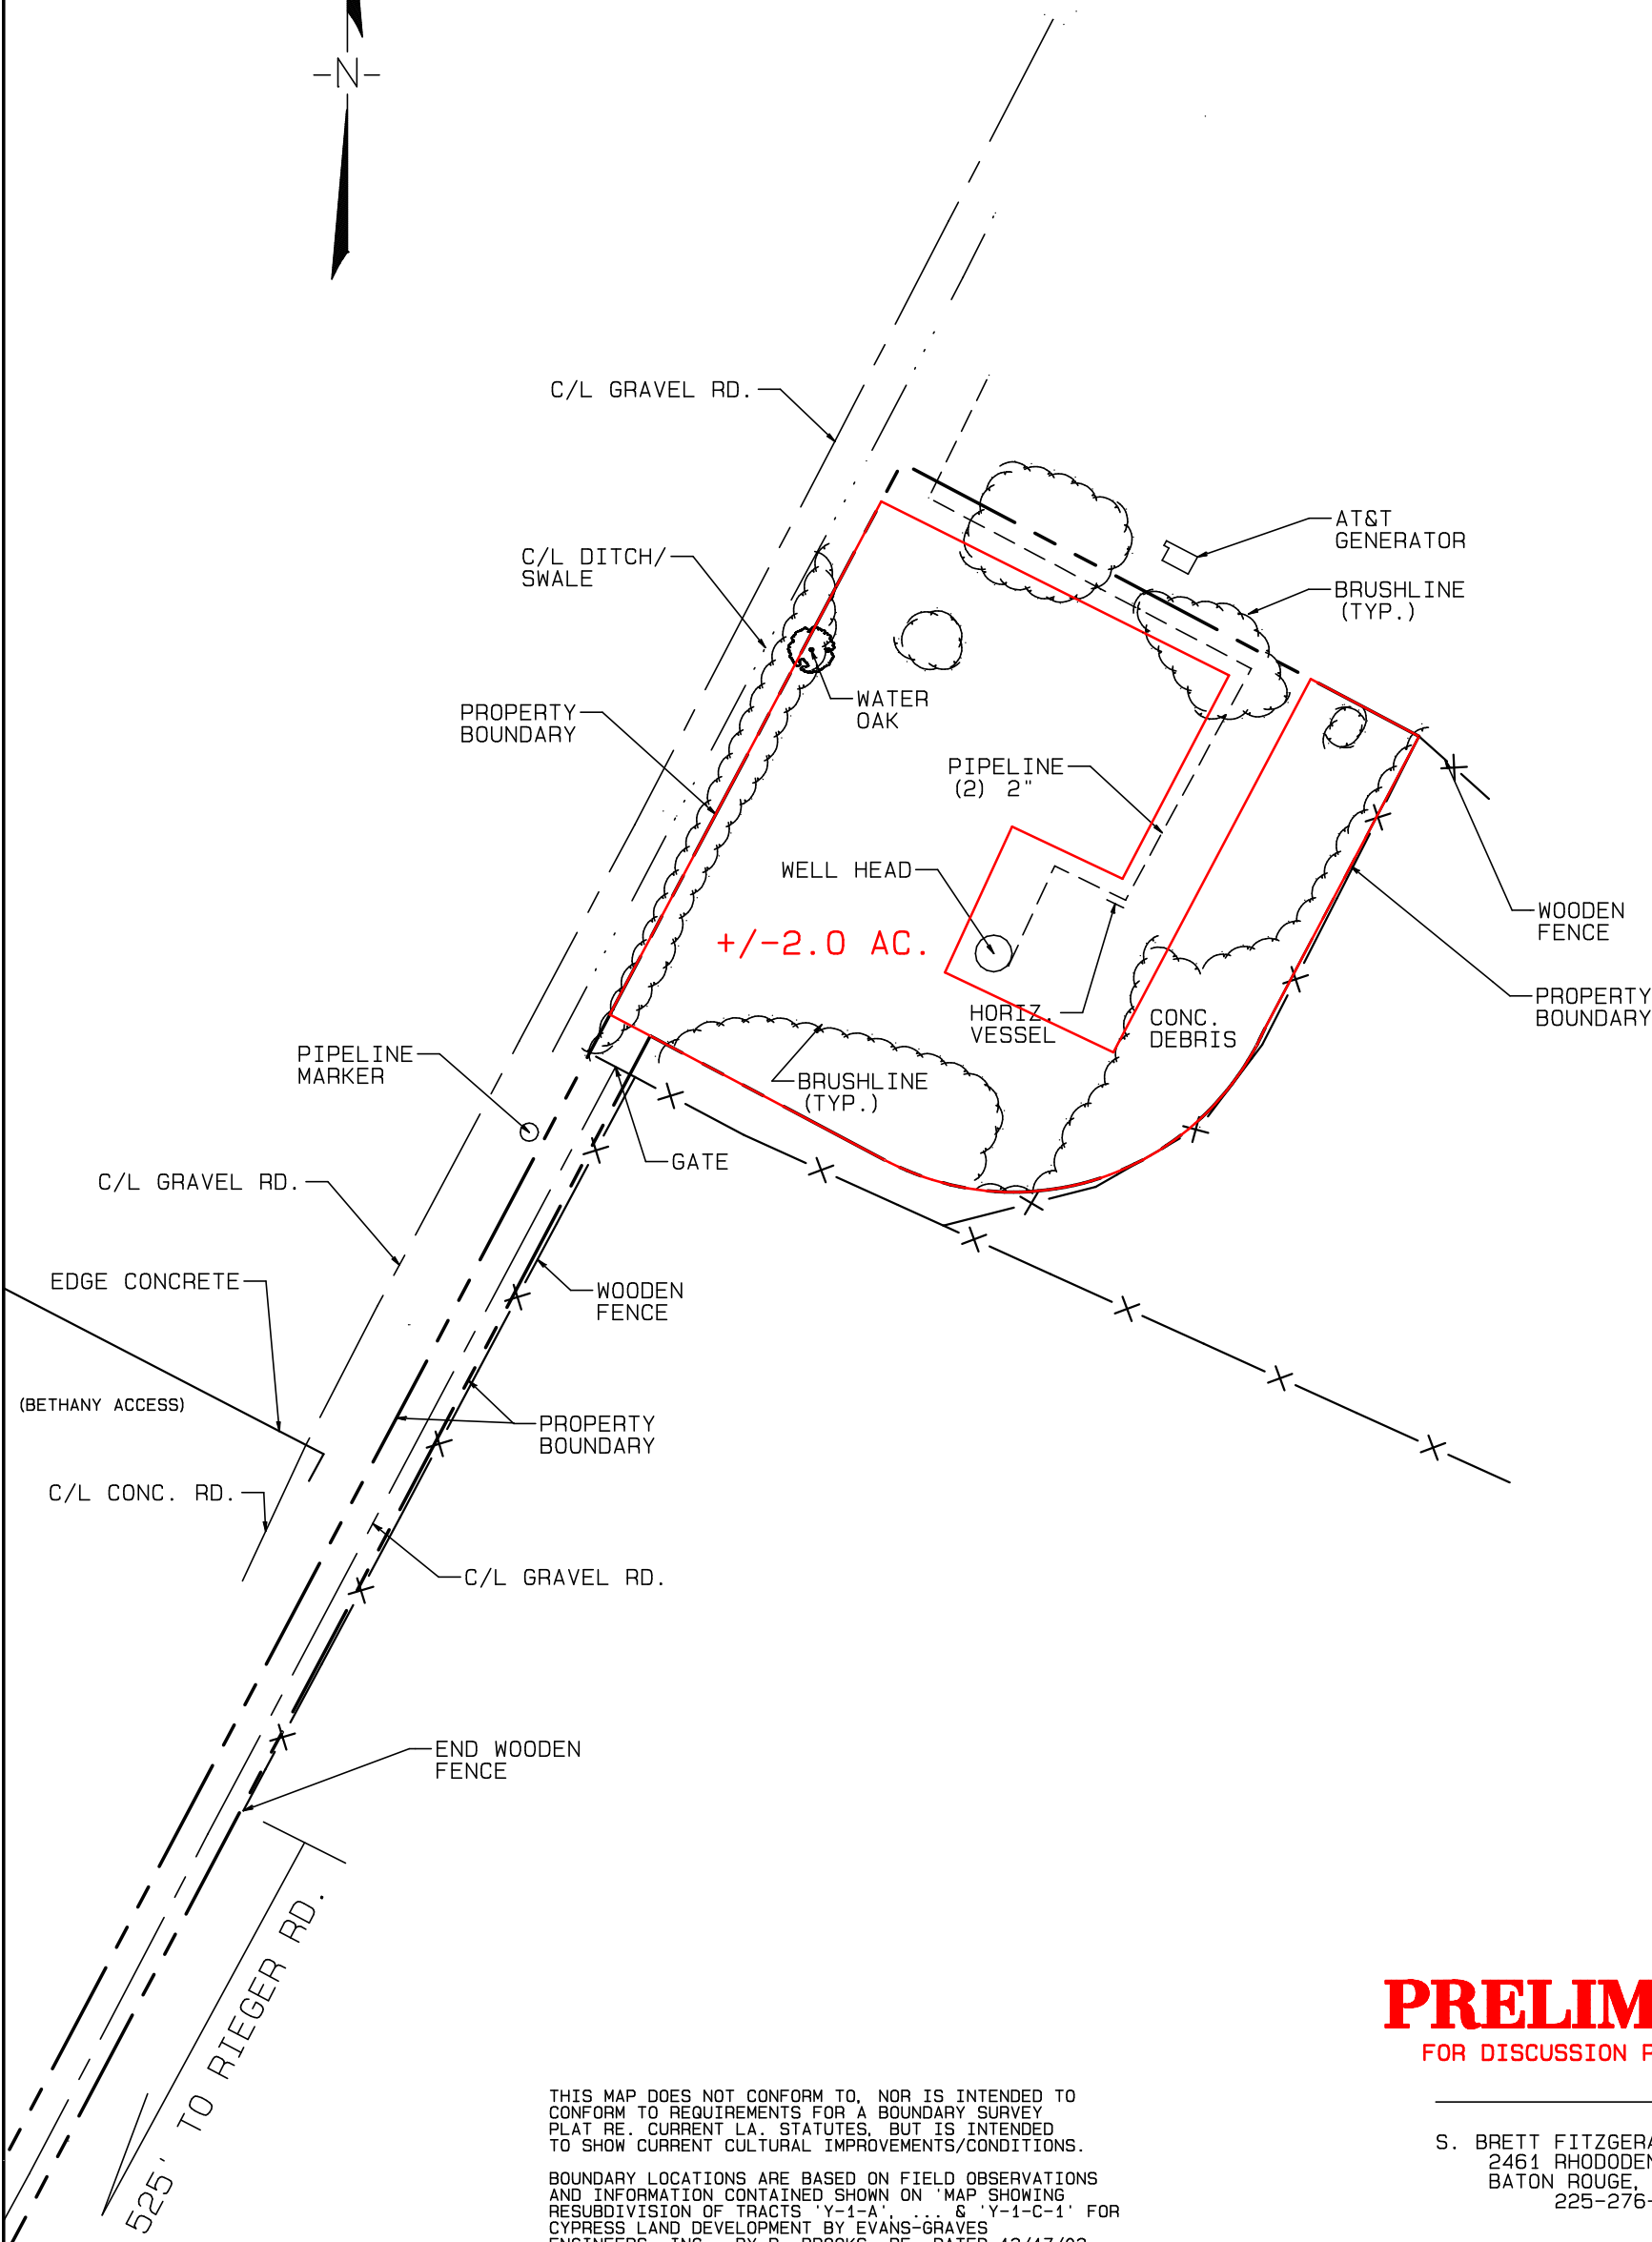


MAP SHOWING IMPROVEMENTS ON
TRACT Y-1-B-2 (2.932 AC.)
OF THE ESTATE OF MRS. ANNIE G. PECUE, et al

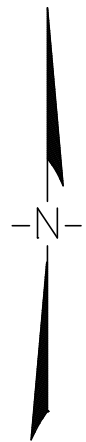

PRELIMINARY
FOR DISCUSSION PURPOSES ONLY

THIS MAP DOES NOT CONFORM TO, NOR IS INTENDED TO CONFORM TO REQUIREMENTS FOR A BOUNDARY SURVEY PLAT RE. CURRENT LA. STATUTES, BUT IS INTENDED TO SHOW CURRENT CULTURAL IMPROVEMENTS/CONDITIONS.

BOUNDARY LOCATIONS ARE BASED ON FIELD OBSERVATIONS AND INFORMATION CONTAINED SHOWN ON 'MAP SHOWING RESUBDIVISION OF TRACTS 'Y-1-A', . . . & 'Y-1-C-1' FOR CYPRESS LAND DEVELOPMENT BY EVANS-GRAVES ENGINEERS, INC., BY R. BROOKS, PE, DATED 12/17/02.


DATE OF SURVEY: 03/18/2015

S. BRETT FITZGERALD, PLS #5018
2461 RHODODENDRON AVE.
BATON ROUGE, LA 70808
225-276-8761

**PLAT SHOWING CONDITIONS
OF TRACT Y-1-B-2
(JENNINGS PROD. CO.)**

**DRAWN FOR
MOREL YORSCH, LLC**

**PROFESSIONAL LAND
SURVEYING SERVICES, LLC**

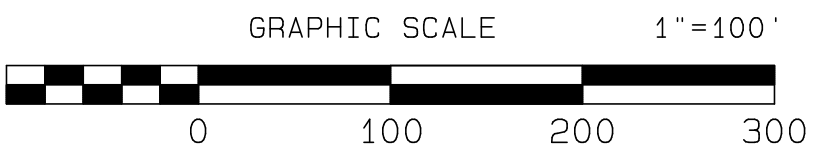

DATE:	03/19/15
DRAWN BY:	DP
CHECKED BY:	SBF
DWG. NO.	B-2023-A