NOTES:
Walls are drawn as 6"
External doors are 3'
Internal doorways were not specified
Dimensions are rounded up to 1/2"
Main Floor middle room is off by 3'

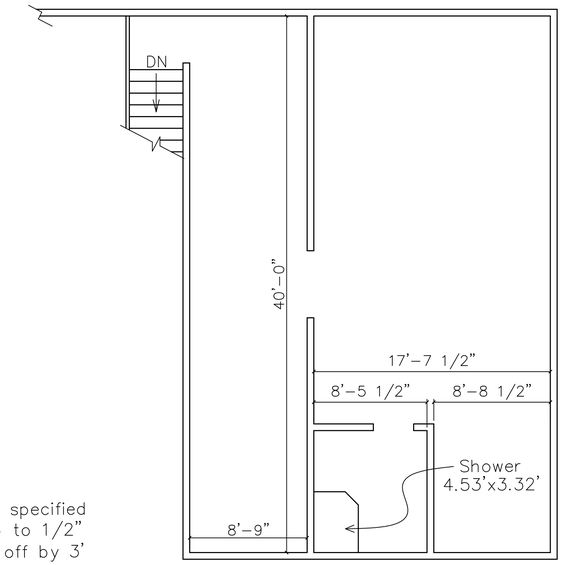

MEZZANINE
SCALE: 3/16" = 1'-0"

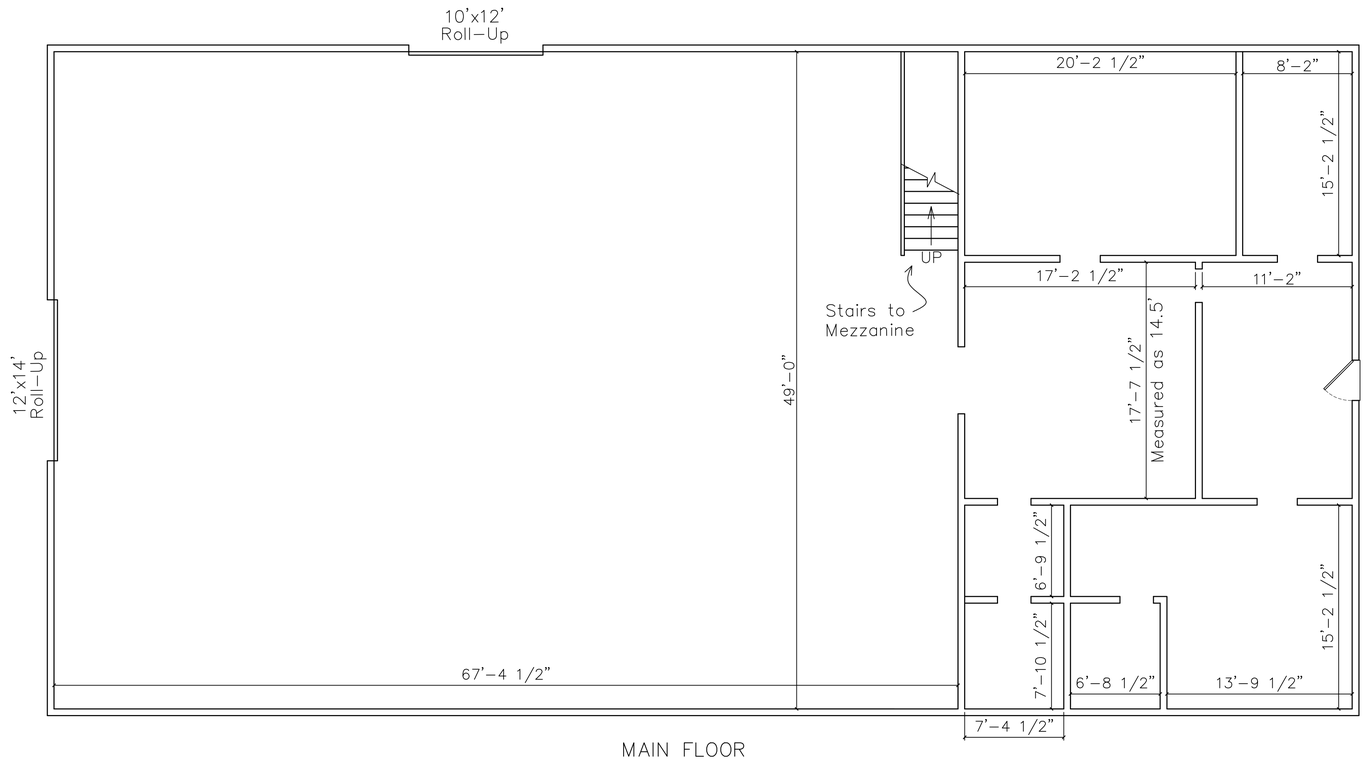

MAIN FLOOR
SCALE: 3/16" = 1'-0"

ColemanAve.dwg

REVISION	DATE

MEASUREMENTS FOR
GARRETT RICHARDSON
DoneRiteHVAC
1000 W. Coleman Ave.
Hammond, LA 70403

DATE APR. 22, 2024
DRAWN FOR G. RICHARDSON
DRAWN BY Z. SLAY

SHEET TITLE: Main Floor & Mezz
SHEET #: a1