


STATE OF LOUISIANA)
 PARISH OF LIVINGSTON) CLERK'S OFFICE
 I CERTIFY THAT THIS INSTRUMENT WAS FILED FOR
 RECORD 4-5 1999 AT 12:05 PM
 AND RECORDED 4-5 1999 IN Plat
 BOOK NO. 419753 ENTRY NO. 419753
 OF THE OFFICIAL RECORDS.
R. J. Jantzen
 DEPUTY CLERK OF COURT AND EX-OFFICIO RECORDER

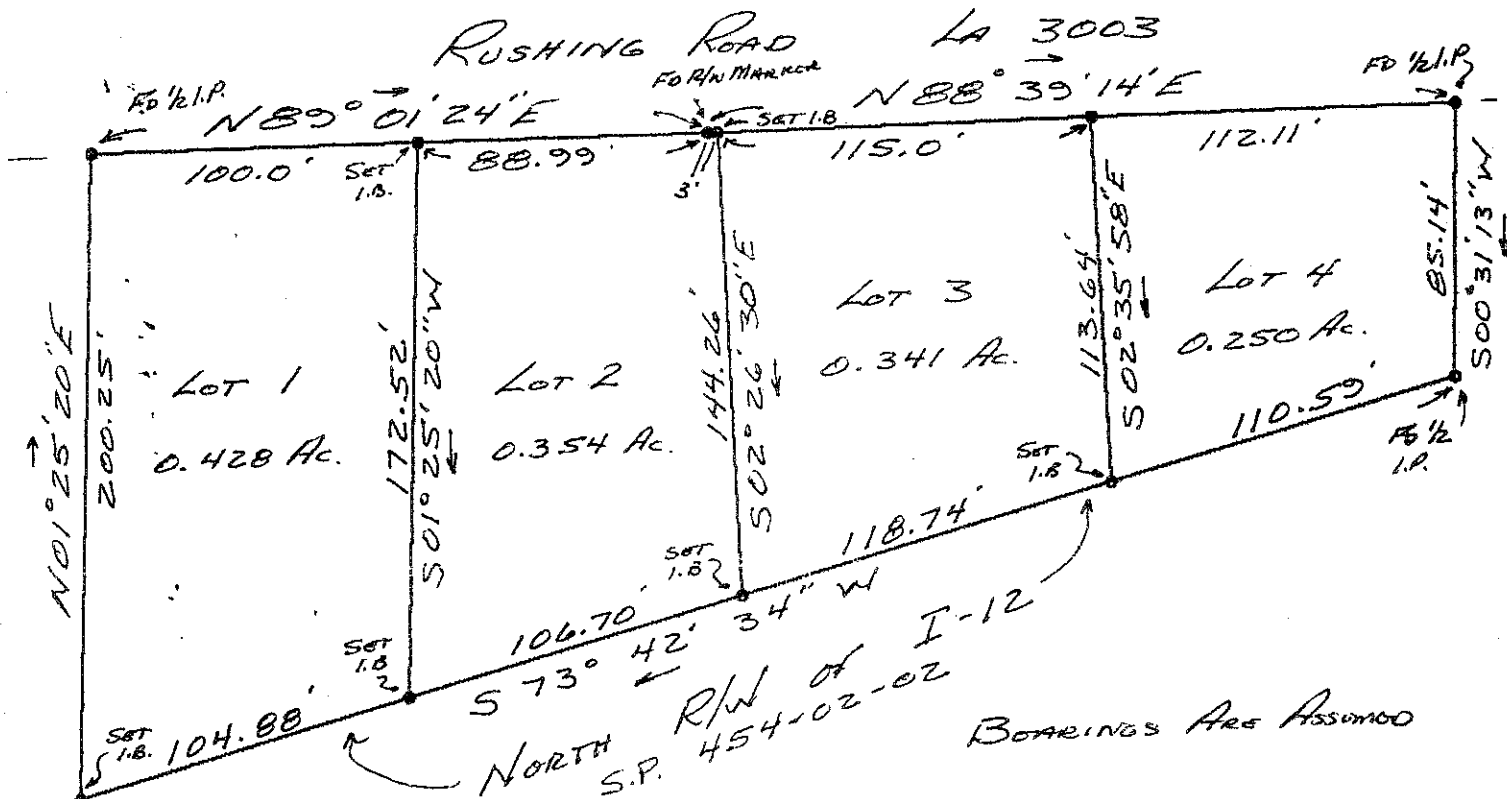


P.O.B. - LOCATED 842.49', S 00° 41' 11" W; 1622.84', N 74° 13' 17" E, 157.02', N 01° 25' 20" E FROM THE NW CORNER OF SECTION 38, T7S R3E.

PLAT OF SURVEY

SHOWING PROPERTY LOCATED IN SECTION 38,
 T-7-S-R-3-E, G.L.D., PARISH OF LIVINGSTON,
 STATE OF LOUISIANA.

NOTE: I certify that this plat represents an actual ground survey and no encroachments exists across any boundary line.

According to the U.S. Dept. of H.U.D. Federal Insurance Flood Hazard Boundary Map dated 9-30-88, Community No 2201130100B, Parish of Livingston, LA., this property does lie within Flood Hazard Zone AE.

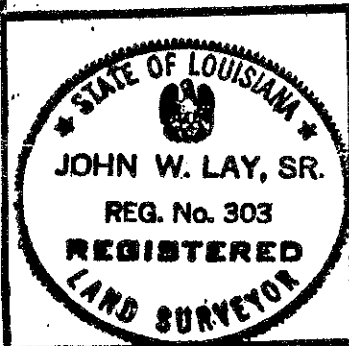

John W. Lay, Sr.

CERTIFIED CORRECT
 JOHN W. LAY, SR. R.L.S.

DATE: 6-16-98

SCALE:
 1" = 60'