



REVIEWED FOR
STATE FIRE MARSHAL
AS PER REVIEW LETTER
BY: GHASSAN HADDAD

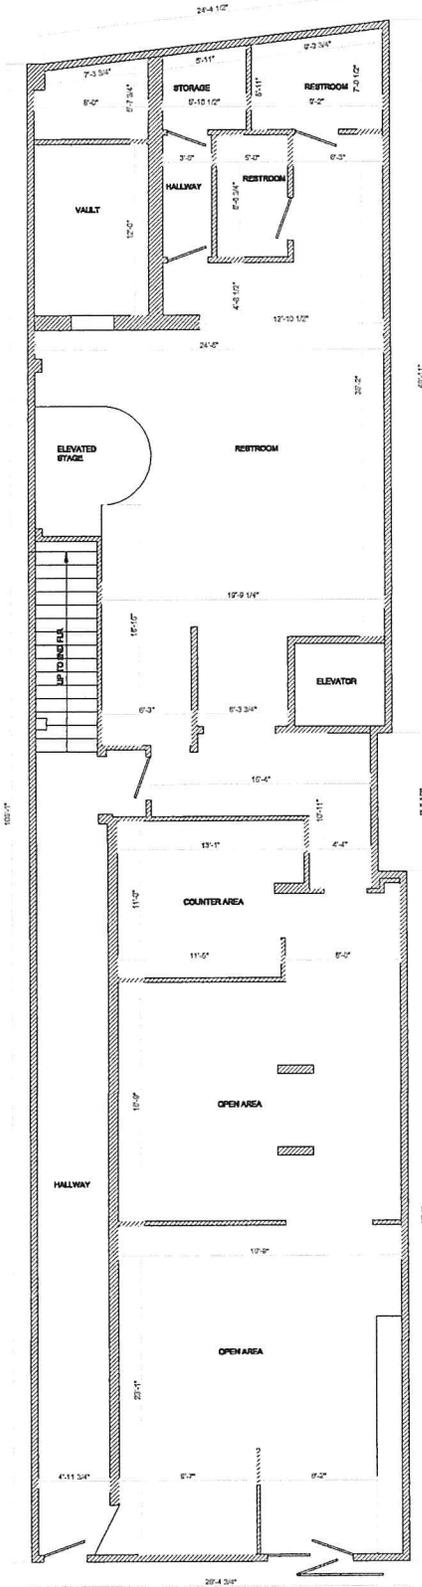


1 FIRST FLOOR PLAN
A1 SCALE: 1/4" = 1'-0"

REVIEWED FOR
STATE FIRE MARSHAL
AS PER REVIEW LETTER
BY: GHASSAN HADDAD

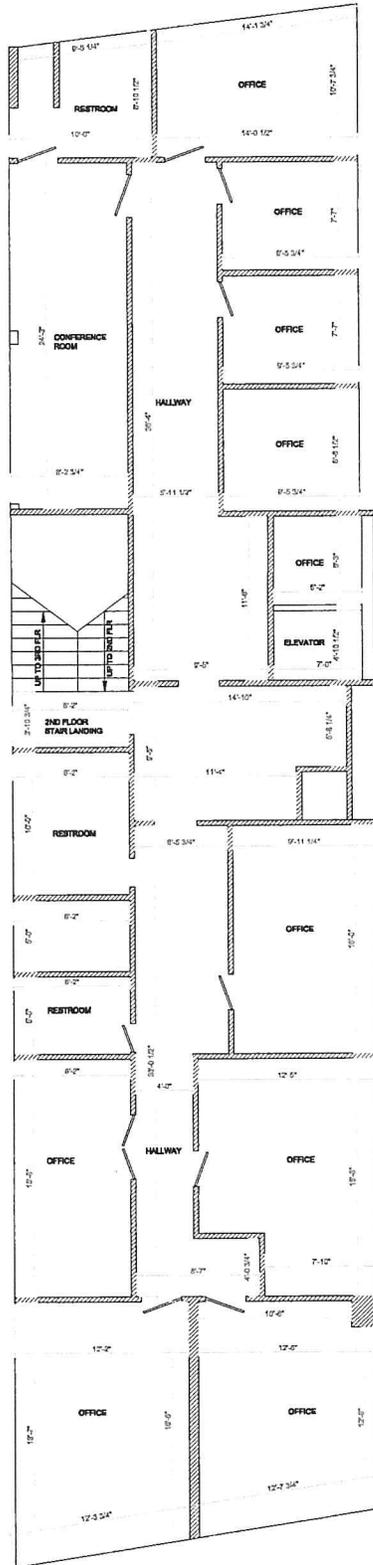

1 SECOND FLOOR PLAN
SCALE: 1/8" = 1'-0"

REVIEWED FOR
STATE FIRE MARSHAL
AS PER REVIEW LETTER
BY: GHASSAN HADDAD

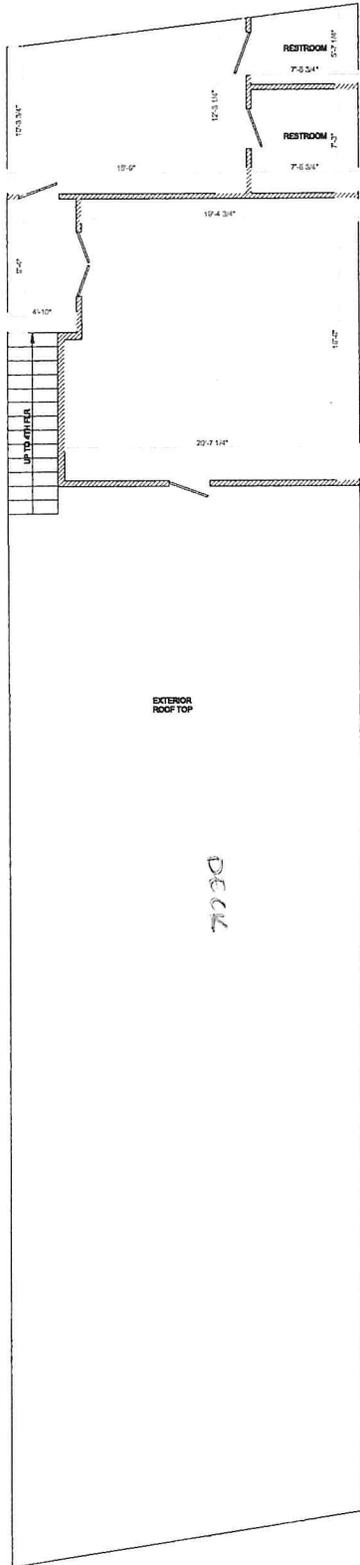

1
M FOURTH FLOOR PLAN
SCALE: 1/8" = 1'-0"

