
99135\SMITH

SURVEYED IN ACCORDANCE WITH THE "LOUISIANA MINIMUM STANDARDS" FOR PROPERTY BOUNDARY SURVEYS FOR A CLASS "D" SURVEY. MADE AT THE REQUEST OF PROBY SMITH.

BEARINGS ARE BASED ON EXISTING RECORD BEARINGS.
REFERENCE MAP: SURVEY MAP BY ANSIL BICKFORD, R.L.S. DATED 1-5-96.

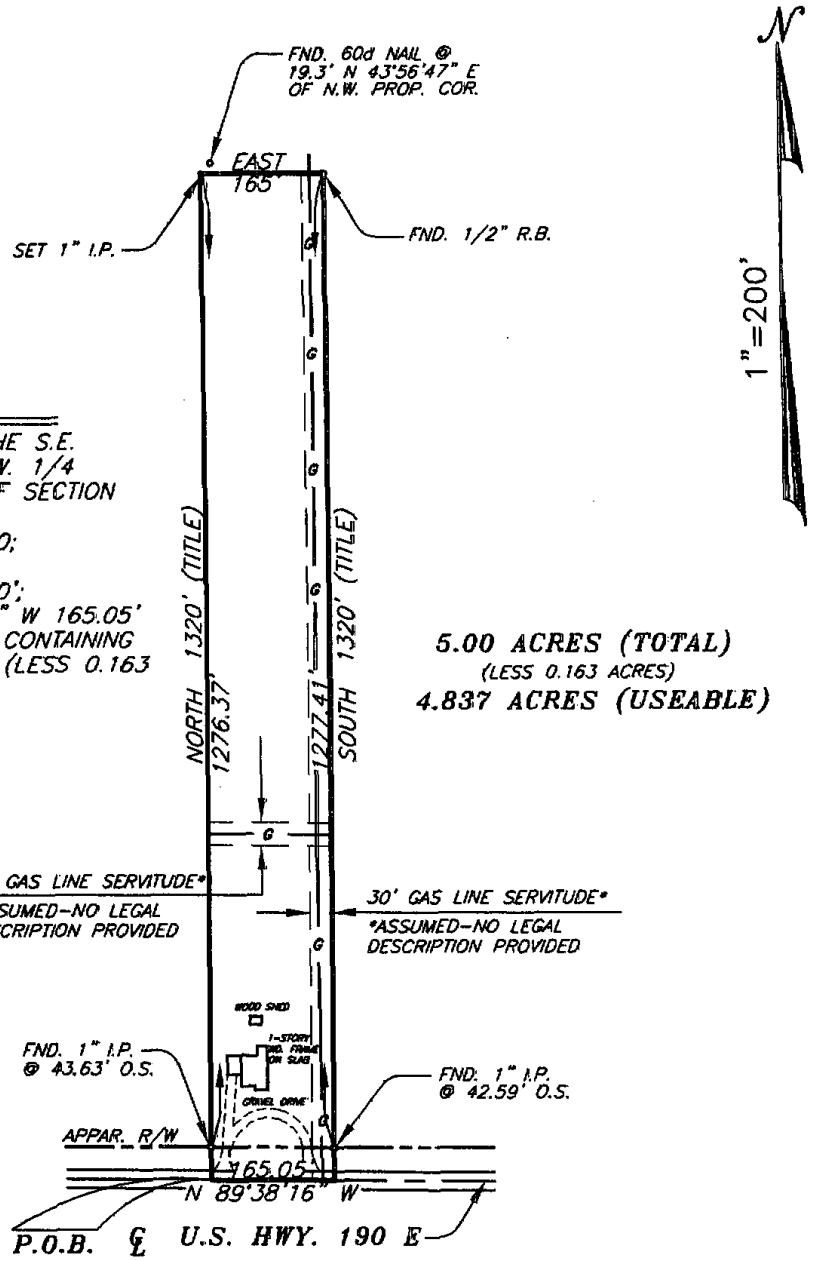

P.O.B. IS:

495.00' WEST OF THE S.E. CORNER OF THE N.W. 1/4 OF THE S.E. 1/4 OF SECTION 19, T6S-R8E: THENCE NORTH 1320; THENCE EAST 165'; THENCE SOUTH 1320'; THENCE N 89°38'16" W 165.05' TO THE P.O.B. AND CONTAINING 5.00 ACRES IN ALL (LESS 0.163 AC. LOST IN R/W).

5.00 ACRES (TOTAL)
(LESS 0.163 ACRES)
4.837 ACRES (USEABLE)

APRIL 9, 1999

A PLAN OF AN ACTUAL GROUND SURVEY OF A 5.00 ACRE PARCEL OF LAND (LESS 0.163 AC. LOST IN R/W) CERTIFYING THAT NO ENCROACHMENTS WERE FOUND TO EXIST EITHER WAY ACROSS ANY PROPERTY LINES OTHER THAN SHOWN, ALL LOCATED IN 19, T6S-R8E, TANGIPAHOA PARISH, LOUISIANA.

THIS PERIMETER SURVEY SHALL NOT CONSTITUTE A LEGAL OPINION OF TITLE, AND SHALL NOT BE RELIED UPON FOR THAT PURPOSE. THERE IS NO WARRANTY THAT IT CONFORMS TO THE LEGAL TITLE, AND WAS MADE SOLELY ACCORDING TO THE INFORMATION PROVIDED THE SURVEYOR.

FLOOD ZONE "X"
(NOT FLOOD PRONE)
MAP NO. 220206-0175-D
DATED: 9-18-91

RZ 2010-10-2 Rec'd 6/8/2010

SURVEY FOR:
1ST GUARANTY BANK

Wm. J. Bodin Jr.

BODIN AND WEBB, INC.
ENGINEERS & SURVEYORS
1024 S. CYPRESS ST.
HAMMOND, LA 70403

JOM