


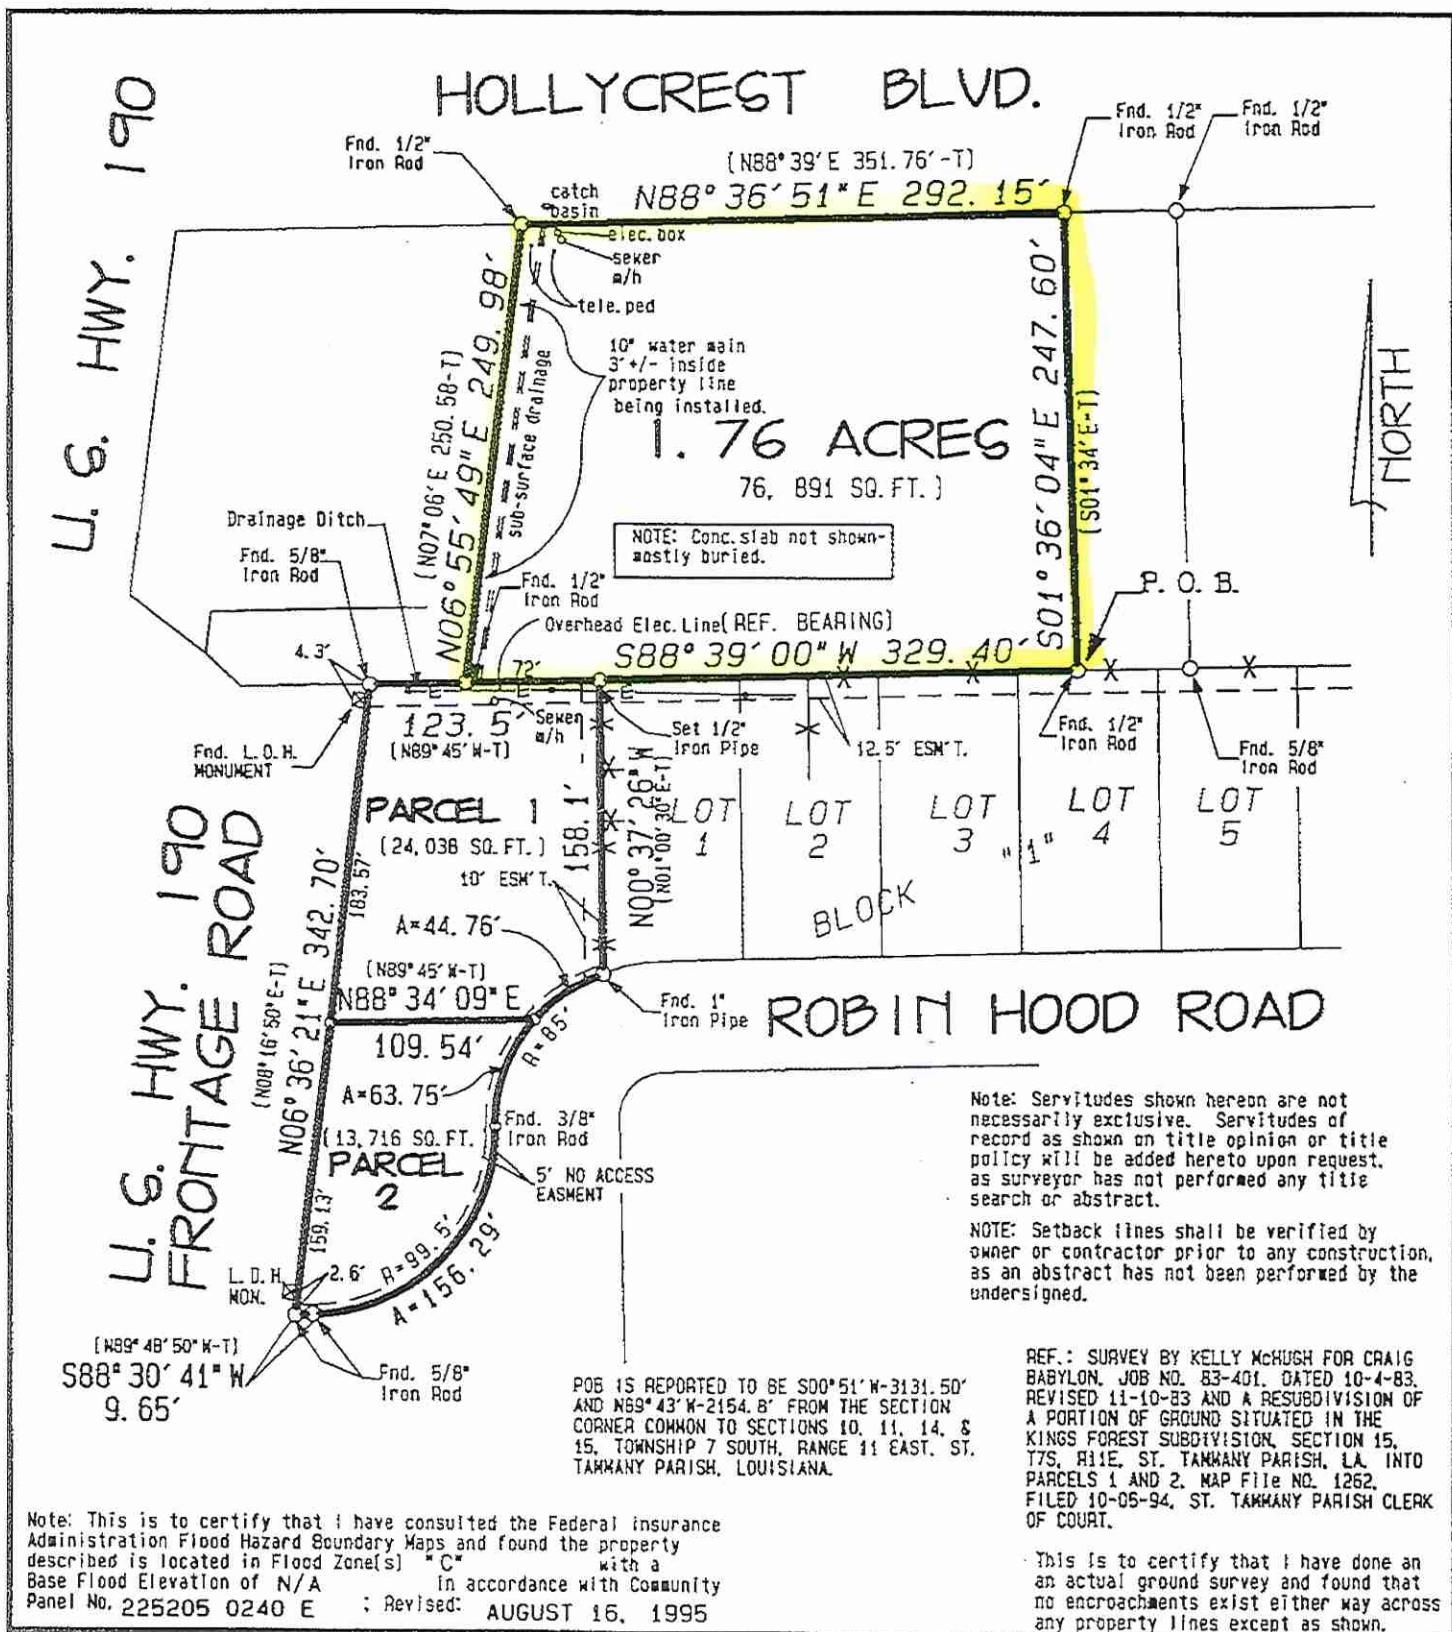

SURVEY MAP OF
1.76 ACRES, SECTION 15, T7S, R11E, AND
PARCELS 1 & 2, KINGS FOREST SUBDIVISION,