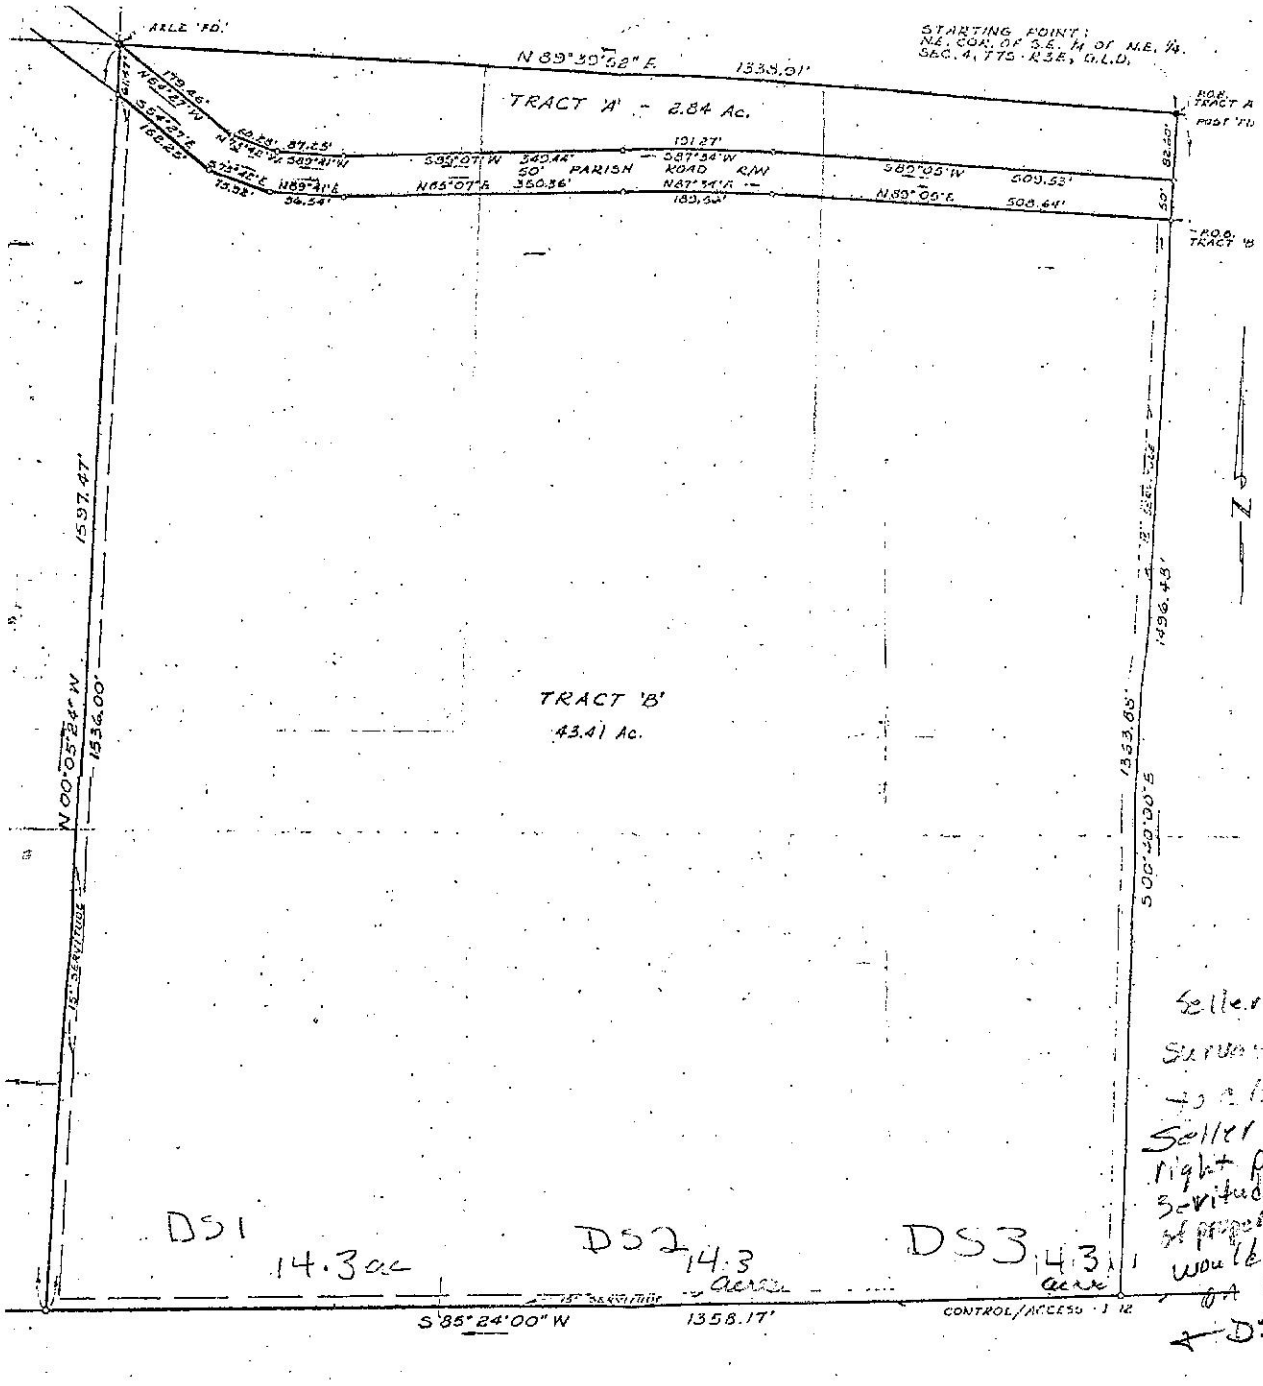


℄ INTERSTATE 12

ACREAGE SUMMARY	
TRACT 'A'	2.84 Ac.
TRACT 'B'	43.41 Ac.
ROAD R/W	1.58 Ac.
TOTAL	47.83 Ac.

DEDICATION: THIS IS TO CERTIFY THAT THE SERVITUDES AND RIGHT OF WAY SHOWN ON THIS PLAT ARE HEREBY DEDICATED IN THE PERPETUAL USE OF THE PUBLIC FOR MEDICAL PURPOSES, INCLUDING DRAINAGE, REMOVAL OF SEWAGE AND ALL UTILITIES. NO TREES, SHRUBS OR PLANTS MAY BE PLANTED NOR SHALL ANY BUILDING, FENCE, STRUCTURE OR ANY OTHER IMPROVEMENTS BE CONSTRUCTED OR INSTALLED WITHIN OR OVER ANY SERVITUDE OR RIGHT OF WAY SO AS TO PREVENT OR UNREASONABLY INTERFERE WITH ANY PURPOSE FOR WHICH THE SERVITUDE OR RIGHT OF WAY IS GRANTED.

SURVEY MAP
FOR
SKEAHAN CORP.

SHOWING CERTAIN TRACTS OF LAND LOCATED IN SEC. 4, T7S-R3E, G.L.D., PARISH OF LIVINGSTON, LOUISIANA

THOMAS SULLIVAN, PRES.
SKEAHAN CORPORATION

ALEX THERIOT, JR., INC.
CONSULTING ENGINEERS
DENHAM SPRINGS, LA.

ALEX THERIOT, JR., L.S.

SEPT. 3, 1975
SCALE: 1" = 100'
FILE NO. 152-63,69-71
JOB NO. 5-523-75-SK

11 p 316