
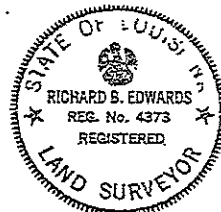


SIERRA PLACE SUBD,
JEFFERSON PARISH, LA.

CYPRESS ST. (SIDE)

RIDGELAKE DR. (SIDE)

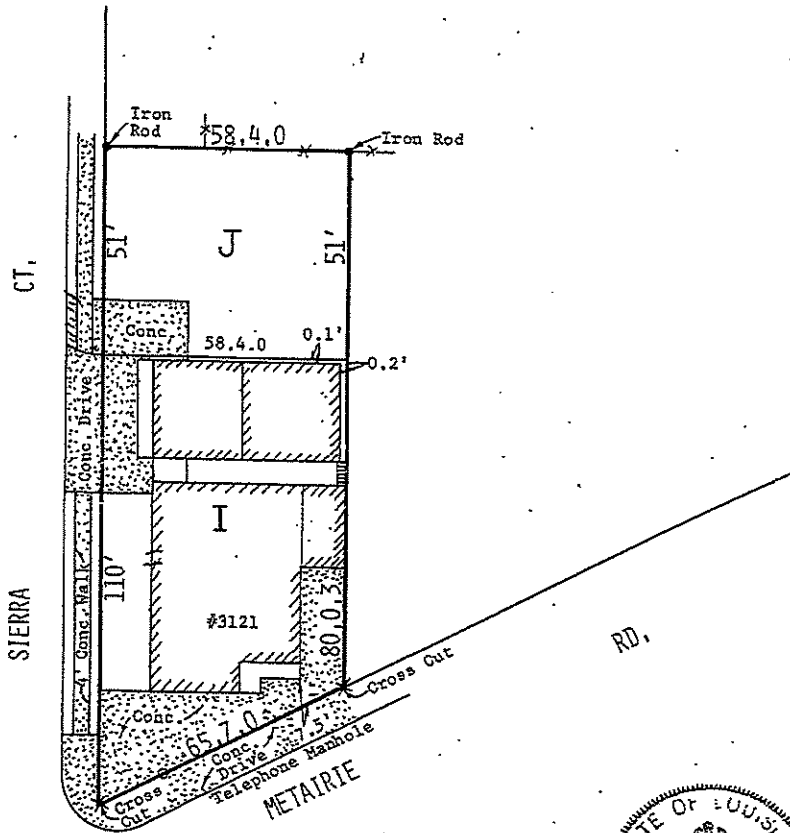

January 8, 1991
SURVEY CERTIFIED CORRECT TO Mr. & Mrs. Carl Melchert

BY Richard S. Edwards MANDLE SURVEYING, INC.
LAND SURVEYORS METAIRIE, LA.