


ALINE ST. (SIDE)

SQ 105
SIXTH DISTRICT

(SIDE)

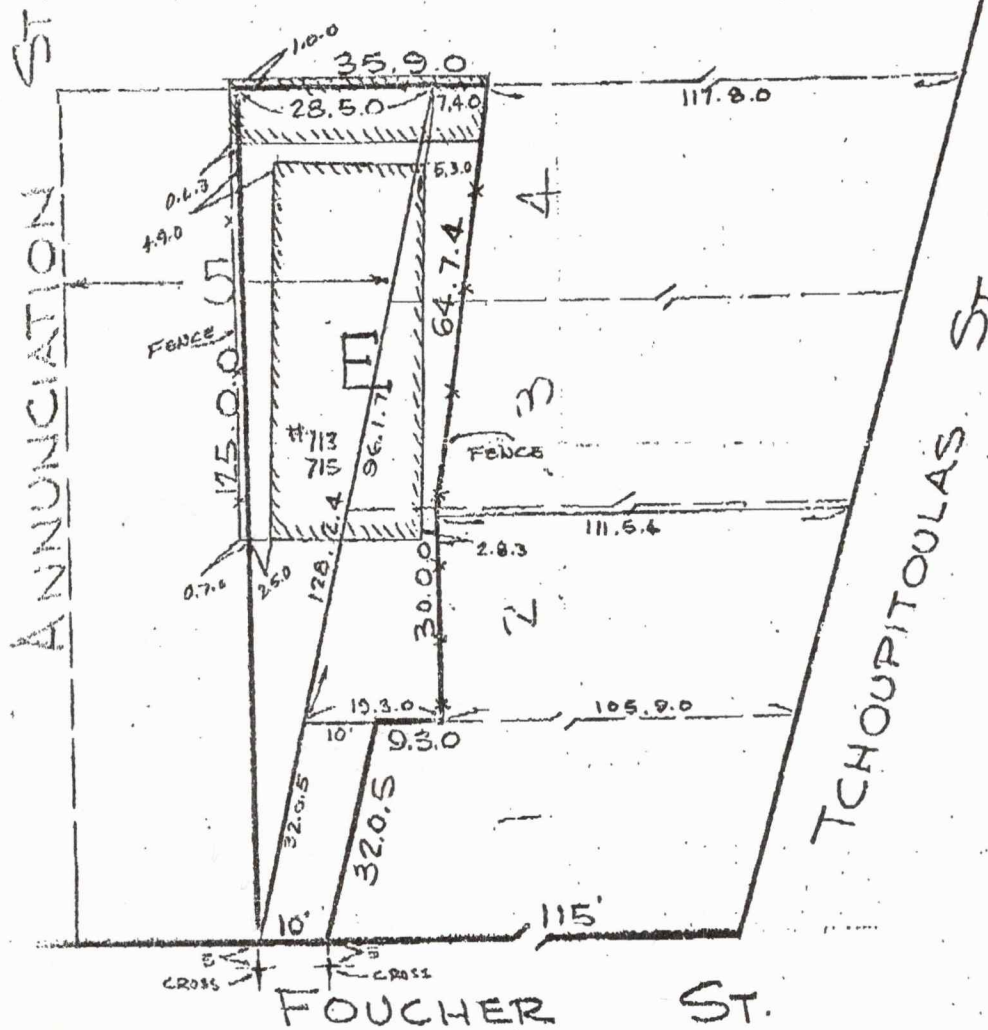

NEW ORLEANS, LA

OCT. 5, 1961

SURVEY MADE AT THE REQUEST OF MR.
ALFRED J. BONOMO JR FOR MR HOWARD A.
LINDER
CERTIFIED CORRECT

J. J. KREBS & SONS
By *John M. Krebs*

Job # 18018