

ANNUNCIATION

ST


(SIDE)

SQ. 105 - DELACHAISE
SIXTH DISTRICT
NEW ORLEANS
ORLEANS PARISH, LA.



ST.

FOUCHER

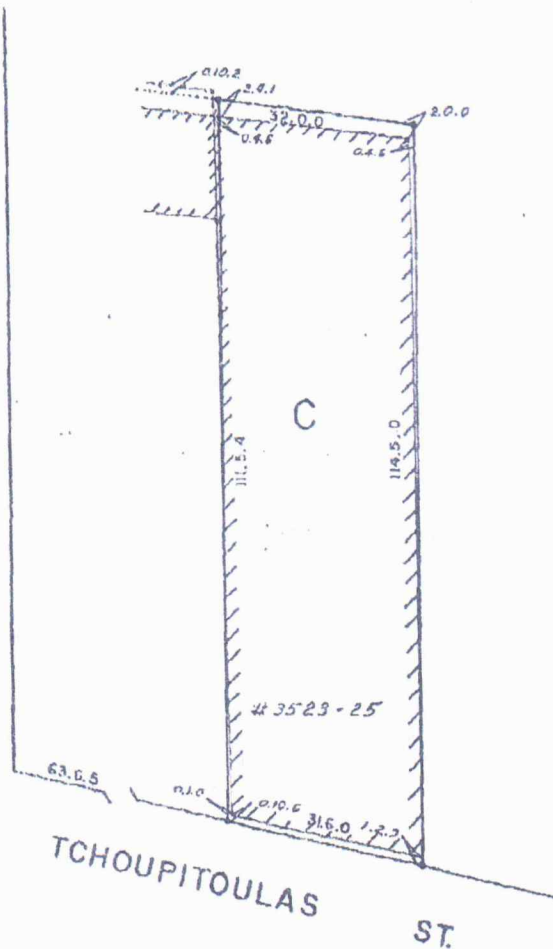

(SIDE)

ST.

ALINE

TCHOUPITOULAS

ST.

METAIRIE, LA. MARCH 3, 1980
SURVEY MADE AT THE REQUEST
OF JESSE S. GUILLOT

CERTIFIED CORRECT
J. J. KREBS & SONS, INC.

BY *[Signature]*

JOB No. 800482